

JACKSON  
 0242

MISSISSIPPI DEPARTMENT OF NATURAL RESOURCES  
 Bureau of Land and Water Resources  
 Southport Mall  
 P.O. Box 10631  
 Jackson, Mississippi 39209  
 WATER WELL DRILLERS LOG

May 2, 1986 date well completed  
 Coast water well src. firm name  
 Jackson county well located

LANDOWNER: Douglas Gilmore  
 3617 Hammill Farm Rd  
 Ocean Springs, MS  
 (mailing address) 39564

description of formations encountered	from to	
	ft	ft
Top Soil	0	2
Blue Clay + Clam shell	2	40
White Coarse Sand	40	62
White Coarse Sand - wood + gravel	62	65

WELL LOCATION:  
 sec. 31 T. 7 S. R. 7 E.  
 2 miles SE of Ocean Springs  
 (distance) (direction) (nearest town)

WELL PURPOSE: home  
 (home, irrigation, municipal, industrial)

- WELL COMPLETION DATA:
- (1) diameter (inches) 2"
  - (2) total depth (feet) 65'
  - (3) static water level (feet) 25' below top of ground.
  - (4) casing PVC, 50' (material), (depth)  
 2" (size) if telescope see back.
  - (5) screen 10', 50' (length), (depth to top)  
 2" (size), PVC (material)
  - (6) pump (HP) (yield gpm)  
 (type power)
  - (7) electric log no (yes or no)  
 (organization running log)
  - (8) how well bottom plugged backwash valve


DRILLERS REMARKS: 5' - 2" PVC tailpipe

RECEIVED  
 JUL 1 1986

Department of Natural Resources  
 Bureau of Land & Water Resources

If well telescopes please sketch and show depths.

GROUND LEVEL

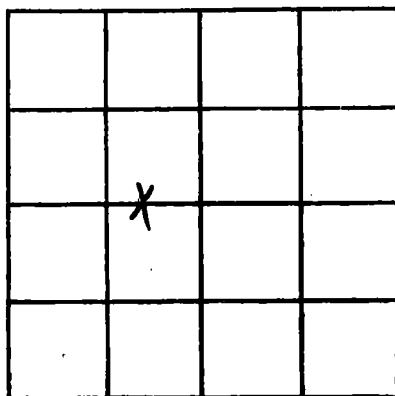

SECTION 31

Please indicate well location X.

ADDITIONAL INFORMATION

If more than one screen,  
show locations of each on sketch.