

MISSISSIPPI DEPARTMENT OF NATURAL RESOURCES

Bureau of Land and Water Resources

Southport Mall

P.O. Box 10631

Jackson, Mississippi 39209

WATER WELL DRILLERS LOG


JACKSON
Φ 2218

6-16-86 19 Coast water well Jackson
 date well completed firm name county well located

LANDOWNER: <u>Ernest Taylor</u>	description of formations encountered	from	to
<u>1820 Anders Rd</u> <u>Gautier mo.</u> (mailing address)			
WELL LOCATION: sec <u>36</u> T <u>7N</u> R <u>7E</u> <u>1N</u> miles (distance) of <u>GAUTIER</u> (direction) of (nearest town)	<u>Top Sand</u>	<u>0</u>	<u>2</u>
WELL PURPOSE: <u>home</u> (home, irrigation, municipal, industrial)	<u>White Coarse Sand</u>	<u>2</u>	<u>5</u>
WELL COMPLETION DATA: (1) diameter (inches) <u>2"</u>	<u>Brown Clay</u>	<u>5</u>	<u>13</u>
(2) total depth (feet) <u>290'</u>	<u>Blue Clay w/ streak of sand</u>	<u>13</u>	<u>46</u>
(3) static water level (feet) <u>19'</u> <u>below</u> top of ground	<u>White Coarse Sand</u>	<u>46</u>	<u>90</u>
(4) casing <u>PVC</u> <u>275'</u> (material) (depth) <u>2"</u> (size) if telescope see back.	<u>Blue Clay</u>	<u>90</u>	<u>102</u>
(5) screen <u>10'</u> <u>275'</u> (length) (depth to top) <u>2"</u> (size) <u>PVC</u> (material)	<u>Gray med Sand</u>	<u>102</u>	<u>105</u>
(6) pump <u>1</u> <u>13</u> (HP) (yield gpm) <u>Elid</u> (type power)	<u>Blue Clay</u>	<u>105</u>	<u>108</u>
(7) electric log <u>no</u> (yes or no)	<u>Gray med Sand</u>	<u>108</u>	<u>160</u>
(organization running log)	<u>Blue Clay</u>	<u>160</u>	<u>195</u>
	<u>Gray med Sand</u>	<u>195</u>	<u>270</u>
	<u>Gray Coarse Sand</u>	<u>270</u>	<u>285</u>
	<u>Blue Clay</u>	<u>285</u>	<u>290</u>
	<u>275</u> <u>10</u> <u>285</u>		<u>192</u>
	RECEIVED		
	AUG 19 1986		
	Department of Natural Resources Bureau of Land & Water Resources		
DRILLERS REMARKS: <u>5' - 2" PVC test pipe</u>			

If well telescopes please
sketch and show depths.

GROUND LEVEL

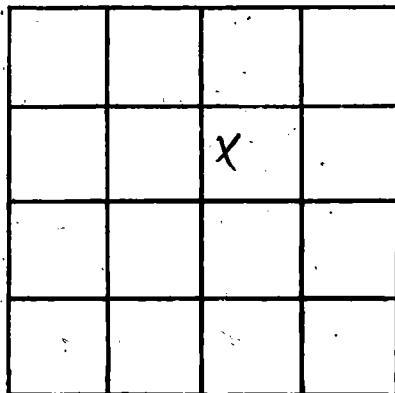

SECTION

36

Please indicate well location X.

ADDITIONAL INFORMATION

If more than one screen,
show locations of each on sketch.