

MISSISSIPPI DEPARTMENT OF NATURAL RESOURCES

Bureau of Land and Water Resources

Southport Mall

P.O. Box 10631

Jackson, Mississippi 39209

WATER WELL DRILLERS LOG

JACKSON  
\$ 22.64

6-18-86 19 Coast Water Well Jackson  
date well completed firm name county well located

LANDOWNER: Matthew McNulty  
3100 Phil Davis Rd  
Ocean Springs, MS  
(mailing address)

description of formations encountered	from	to
Top soil	0	1
White Coarse Sand	1	18
Blue Clay	18	50
White Coarse sand	50	71
Blue Clay	71	134
Gray med sand	134	146
Blue Clay	146	208
Gray Fine Sand	208	215
Blue Clay	215	265
Blue clay w/ streaks of sand	265	285
Gray Fine Sand	285	305
Blue Clay	305	459
Gray med sand	459	465
Blue Clay	465	500
Gray med sand	500	550
Blue Clay	550	555

WELL LOCATION:  
sec. 32 T 7 N R 7 E  
4 miles West of GAUTIER  
(distance) (direction) (nearest town)

WELL PURPOSE: Home  
(home, irrigation, municipal, industrial)

WELL COMPLETION DATA:

(1) diameter (inches) 2"

(2) total depth (feet) 555'

(3) static water level (feet) 80' below top of ground

(4) casing PUC, 540' (material), (depth)  
2' (size) if telescope see back.

(5) screen 10' 540' (length), (depth to top)  
2" (size), PUC (material)

(6) pump 1 (HP), 5 1/2 (yield gpm)  
Elect (type power)

(7) electric log no (yes or no)  
(organization running log)


(8) how well bottom plugged Backwash valve

DRILLERS REMARKS:  
5' - 2" PUC tail pipe

540' Department of Natural Resources  
Bureau of Land & Water Resources

If well telescopes please sketch and show depths.

GROUND LEVEL

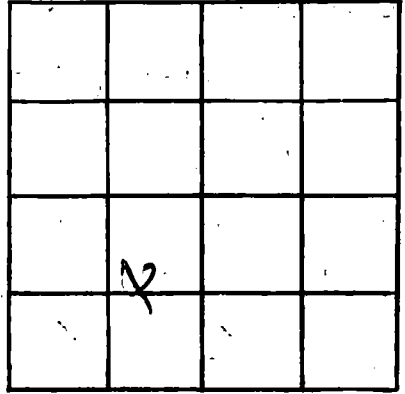

SECTION 32

Please indicate well location X.

ADDITIONAL INFORMATION

If more than one screen, show locations of each on sketch.