

**JACKSON**  
 # 2267

MISSISSIPPI DEPARTMENT OF NATURAL RESOURCES  
 Bureau of Land and Water Resources  
 Southport Mall  
 P.O. Box 10631  
 Jackson, Mississippi 39209  
**WATER WELL DRILLERS LOG**

7-16 19 86 Coast Water Well Serv. JACKSON  
 date well completed firm name county well located

LANDOWNER: Tammy Ditcher

description of formations encountered	from	to
<u>TOP SOIL</u>	<u>0</u>	<u>1</u>

3813 SHAMROCK DR.

<u>WHITE COARSE SAND</u>	<u>1</u>	<u>5</u>
--------------------------	----------	----------

Gautier, Ms. 39553  
 (mailing address)

WELL LOCATION:

sec 36 T 7 N 7 E  
 (S) (W)  
1/2 miles (distance) ← (direction) of GAUTIER (nearest town)

<u>BROWN CLAY</u>	<u>5</u>	<u>10</u>
-------------------	----------	-----------

<u>WHITE COARSE SAND</u>	<u>10</u>	<u>13</u>
--------------------------	-----------	-----------

WELL PURPOSE: HOME  
 (home, irrigation, municipal, industrial)

<u>BLUE CLAY</u>	<u>13</u>	<u>25</u>
------------------	-----------	-----------

<u>WHITE COARSE SAND</u>	<u>25</u>	<u>30</u>
--------------------------	-----------	-----------

WELL COMPLETION DATA:

(1) diameter (inches) 2"  
 (2) total depth (feet) 75'

<u>BLUE CLAY</u>	<u>30</u>	<u>44</u>
------------------	-----------	-----------

<u>WHITE COARSE SAND</u>	<u>44</u>	<u>70</u>
--------------------------	-----------	-----------

(3) static water level (feet) 19' <sup>below</sup> (circled) top of ground.

<u>BLUE CLAY</u>	<u>70</u>	<u>75</u> <u>hole</u>
------------------	-----------	--------------------------

(4) casing PVC 60' (material) (depth)  
2" (size) if telescope see back.

60  
10  
-----  
will be 70

(5) screen 10' 60' (length) (depth to top)

2" (size) PVC. (material)

(6) pump 1/2 8 (HP) (yield gpm)

elec. (type power)

(7) electric log NO (yes or no)

**RECEIVED**

AUG 26 1986

(organization running log)

(8) how well bottom plugged BACKWASH VALVE


Department of Natural Resources  
 Bureau of Land & Water Resources

DRILLERS REMARKS: 2" x 5' PVC.

Tailpipe on bottom of well

If well telescopes please sketch and show depths.

GROUND LEVEL

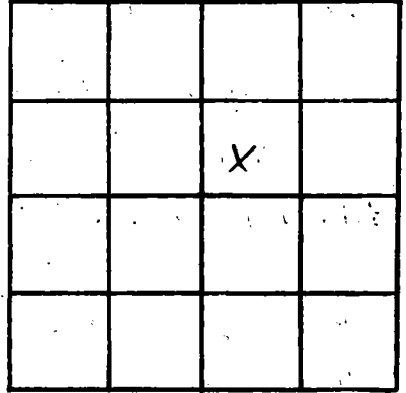

SECTION

36

Please indicate well location X.

ADDITIONAL INFORMATION

If more than one screen, show locations of each on sketch.