

MISSISSIPPI DEPARTMENT OF NATURAL RESOURCES

Bureau of Land and Water Resources

P.O. Box 10631

Jackson, Mississippi 39209

WATER WELL DRILLERS LOG

COUNTY WELL LOCATED Jackson	
WELL NUMBER 2275	CODED
DATE WELL COMPLETED 12-10-86	

PERMIT NUMBER
NAME OF DRILLING FIRM Oakwater Well

NAME & MAILING ADDRESS OF LANDOWNER Jimmy Maeller		
MARY MAHONEY DR		
Ocean Springs, Ms		
WELL LOCATION: SEC	TOWNSHIP	RANGE
5	8	7
DISTANCE 3 1/2 Miles	DIRECTION SE	NEAREST TOWN OCEAN SPRINGS
OTHER LANDMARK		
WELL PURPOSE: Home, Irrigation, Municipal, Industrial, Fish Pond, etc. home.		

PUMP DATA		
PUMP TYPE (Circle One): Submersible, Turbine, Jet Flowing Well, Other (Describe)		
POWER TYPE (Circle One): Electric , Tractor, Diesel, Gasoline, Butane, Other (Describe)		
Pump Capacity (GPM) 12	No. of Stages 2	Setting Depth FT.
PUMP TEST		
Well yielded _____ GPM with a drawdown of _____ ft. after _____ hours of pumping		

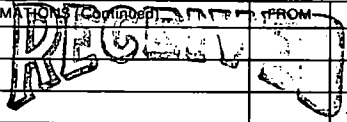
WELL DATA		
Well Depth 300	Casing Diameter (In.) 2"	Casing Length (Ft.) 340'
Type of Casing PUC	Hole Depth 365'	Depth to Static Water Level 15'
TYPE OF COMPLETION: (Circle One or More): Natural Development , Gravel Packed, Underreamed, Telescoped, Open Hole, Other		
Top of Lap Pipe or Reduction in Casing		
FEET <input type="checkbox"/> IF TELESCOPED OR MORE THAN ONE SCREEN: USE BACK PAGE		

LOG DATA	
TYPE OF LOG RUN (Circle One): Electric, Gamma Ray, Density, Sonic, No Log Run , Neutron, Other (Describe)	
Name of Organization Running Log	

SCREEN DATA		
Diameter - Inches 2"	Length - Feet 20'	Slot Size - Inches .008
Screen Type PUC		Depth to Bottom - Feet 360

GEOLOGIC DATA (Office Use Only)			
Surface Elev.	Geologic Unit	Unit Thickness	Depth to Top
Subs. SWL	Date	Analysis	Aquifer Test
Driller's Remarks			

DESCRIPTION OF FORMATIONS ENCOUNTERED	FROM	TO
White Coarse Sand	0	12
Blue Clay	12	15
White Coarse Sand	15	31
Blue Clay	31	44
White Coarse Sand	44	60
Blue Clay	60	104
Gray Med Sand	104	181
Blue Clay	181	325
Gray Coarse Sand	325	360
Blue Clay	360	365

 MAY 21 1987 Department of Natural Resources Bureau of Land & Water Resources		
IF MORE SPACE IS NEEDED, USE BACK		

If well telescopes please
sketch and show depths.

GROUND LEVEL

X			

SECTION 5

Please indicate well location X.

ADDITIONAL INFORMATION

If more than one screen,
show location of each on sketch.