

MISSISSIPPI DEPARTMENT OF NATURAL RESOURCES
Bureau of Land and Water Resources

P.O. Box 10631

Jackson, Mississippi 39209

WATER WELL DRILLERS LOG

COUNTY WELL LOCATED Jackson	
WELL NUMBER Ø 2282	CODED
DATE WELL COMPLETED 3-13-87	

PERMIT NUMBER
NAME OF DRILLING FIRM Coast Waterwell Service

NAME & MAILING ADDRESS OF LANDOWNER Oscar Wallace			
7900 Ocean Springs Rd			
Ocean Springs MS			
WELL LOCATION:	SEC	TOWNSHIP	RANGE
	18	7 N	7 W
DISTANCE	DIRECTION	NEAREST TOWN	
4 Miles	NW	of O. Springs	
OTHER LANDMARK			
WELL PURPOSE: Home, Irrigation, Municipal, Industrial, Fish Pond, etc. home			

PUMP DATA		
PUMP TYPE (Circle One): Submersible, Turbine, Jet Flowing Well, Other (Describe) _____		
POWER TYPE (Circle One): Electric , Tractor, Diesel, Gasoline, Butane, Other (Describe) _____		
Pump Capacity (GPM) 7	No. of Stages 2	Setting Depth - FT.
PUMP TEST		
Well yielded _____ GPM with a drawdown of _____ ft. after _____ hours of pumping		


WELL DATA		
Well Depth 366' 3/4"	Casing Diameter (In.) 2"	Casing Length (Ft.) 351'
Type of Casing Prc	Hole Depth 366'	Depth to Static Water Level 55'
TYPE OF COMPLETION: (Circle One or More): Gravel Packed, Underreamed, Telescoped, Natural Development , Open Hole, Other (Describe) _____		
Top of Lap Pipe or Reduction in Casing		
FEET	IF TELESCOPED OR MORE THAN ONE SCREEN: USE BACK PAGE	

LOG DATA	
TYPE OF LOG RUN (Circle One): Electric, Gamma Ray, Density, Sonic, No Log Run , Neutron, Other (Describe) _____	
Name of Organization Running Log	

SCREEN DATA		
Diameter - Inches 2"	Length - Feet 10'	Slot Size - Inches .008
Screen Type Prc	Depth to Bottom - Feet 361'	

GEOLOGIC DATA (Office Use Only)			
Surface Elev.	Geologic Unit	Unit Thickness	Depth to Top
Subs. SWL	Date	Analysis	Aquifer Test


Driller's Remarks

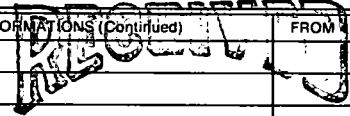DESCRIPTION OF FORMATIONS ENCOUNTERED	FROM	TO	FORMATIONS (Continued)	FROM	TO
Sand	0	2	 MAY 21 1987 Department of Natural Resources Bureau of Land & Water Resources		
Blue Clay	2	33			
White Coarse Sand	33	50			
Blue Clay	50	60			
White Coarse Sand	60	80			
Blue Clay	80	100			
White Coarse Sand	100	125			
Blue Clay	125	340			
Gray Coarse Sand	340	361			
Blue Clay	361	366			

IF MORE SPACE IS NEEDED, USE BACK

If well telescopes please sketch and show depths.

GROUND LEVEL

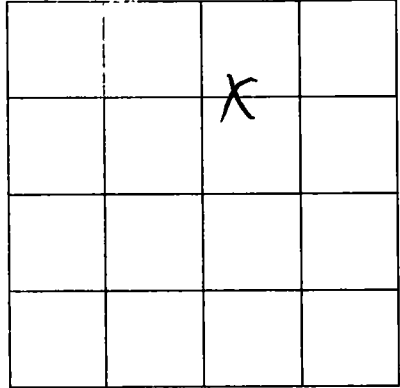

SECTION 18

Please indicate well location X.

ADDITIONAL INFORMATION

If more than one screen,
show location of each on sketch.