

MISSISSIPPI DEPARTMENT OF NATURAL RESOURCES
Bureau of Land and Water Resources

P.O. Box 10631
Jackson, Mississippi 39209
WATER WELL DRILLERS LOG

COUNTY WELL LOCATED	
Jackson	
WELL NUMBER	CODED
02284	
DATE WELL COMPLETED	
4-15-87	

PERMIT NUMBER
NAME OF DRILLING FIRM
Coast Water Well Svc. Inc.

NAME & MAILING ADDRESS OF LANDOWNER			
Jerry Windham			
5816 David Davis Place			
Ocean Springs Ms			
WELL LOCATION:	SEC	TOWNSHIP	RANGE
	51	7 N	9 E
DISTANCE	DIRECTION	NEAREST TOWN	
5	S	Dampfler	
OTHER LANDMARK			
WELL PURPOSE: Home, Irrigation, Municipal, Industrial, Fish Pond, etc.			
home			

PUMP DATA		
PUMP TYPE (Circle One):		
Submersible,	Turbine,	<input checked="" type="radio"/> Jet
Flowing Well, Other (Describe) _____		
POWER TYPE (Circle One):		
<input checked="" type="radio"/> Electric	Tractor,	Diesel, Gasoline, Butane,
Other (Describe) _____		
Pump Capacity (GPM)	No. of Stages	Setting Depth
8	2	— FT.
PUMP TEST		
Well yielded _____ GPM with		
a drawdown of _____ ft.		
after _____ hours of pumping		

WELL DATA		
Well Depth	Casing Diameter (In.)	Casing Length (Ft.)
408	2"	393'
Type of Casing	Casing Depth	Depth to Static Water Level
PVC	408'	55'
*TYPE OF COMPLETION: (Circle One or More):		
<input checked="" type="checkbox"/> Gravel Packed,	<input type="checkbox"/> Underreamed,	<input type="checkbox"/> Telescoped,
<input checked="" type="checkbox"/> Natural Development,	<input type="checkbox"/> Open Hole,	<input type="checkbox"/> Other
(Describe) _____		
Top of Lap Pipe or Reduction in Casing		
FEET	IF TELESCOPED OR MORE THAN ONE SCREEN: USE BACK PAGE	

LOG DATA	
TYPE OF LOG RUN (Circle One):	
Electric, Gamma Ray, Density, Sonic,	<input checked="" type="radio"/> No Log Run, Neutron,
Other (Describe) _____	
Name of Organization, Running Log	

SCREEN DATA		
Diameter - Inches	Length - Feet	Slot Size - Inches
2"	10'	.008
Screen Type	Depth to Bottom - Feet	
PVC	403'	

GEOLOGIC DATA (Office Use Only)			
Surface Elev.	Geologic Unit	Unit Thickness	Depth to Top
Subs. SWL	Date	Analysis	Aquifer Test
Driller's Remarks			

DESCRIPTION OF FORMATIONS ENCOUNTERED	FROM	TO	FORMATIONS (Continued)	FROM	TO
Top Soil	0	2	Gray med sand	360	408
White coarse sand	2	10			
Blue Clay	10	62			
White coarse sand	62	90			
Blue Clay	90	125			
Gray coarse sand	125	190			
Blue Clay	190	243			
Gray med sand	243	260			
Blue Clay	260	360			

RECEIVED


MAY 21 1987

Department of Natural Resources
Bureau of Land & Water Resources

IF MORE SPACE IS NEEDED, USE BACK

If well telescopes please sketch and show depths.

GROUND LEVEL

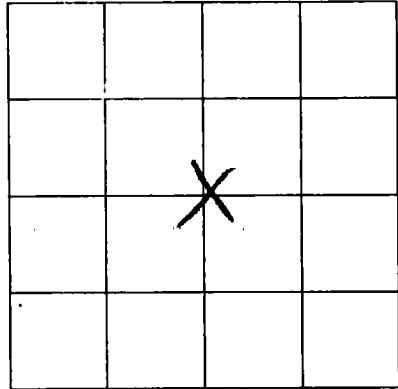

SECTION

57

Please indicate well location X.

ADDITIONAL INFORMATION

If more than one screen,
show location of each on sketch.