

add-loc-pump

MISSISSIPPI DEPARTMENT OF NATURAL RESOURCES
Bureau of Land and Water Resources

P.O. Box 10631

Jackson, Mississippi 39209
WATER WELL DRILLERS LOG

COUNTY WELL LOCATED Jackson
WELL NUMBER CODED CP 2293
DATE WELL COMPLETED 6-23-87

PERMIT NUMBER
NAME OF DRILLING FIRM Coast Water Well Service

NAME & MAILING ADDRESS OF LANDOWNER Dag Construction 3203 Pascagoula Pascagoula
WELL LOCATION: SEC 4 TOWNSHIP 8 RANGE 7
DISTANCE 2 1/2 Miles DIRECTION W of NEAREST TOWN GAUTIER
OTHER LANDMARK
WELL PURPOSE: Home, Irrigation, Municipal, Industrial, Fish Pond, etc. home

PUMP DATA		
PUMP TYPE (Circle One): Submersible, Turbine, Jet , Flowing Well, Other (Describe) _____		
POWER TYPE (Circle One): Electric , Tractor, Diesel, Gasoline, Butane, Other (Describe) _____		
Pump Capacity (GPM) 8	No. of Stages 2	Setting Depth FT.
PUMP TEST		
Well yielded _____ GPM with a drawdown of _____ ft. after _____ hours of pumping		

WELL DATA		
Well Depth 540'	Casing Diameter (In.) 2"	Casing Length (Ft.) 515'
Type of Casing PVC	Hole Depth 540'	Depth to Static Water Level 50'
TYPE OF COMPLETION: (Circle One or More): Gravel Packed, Underreamed, Telescoped, Natural Development , Open Hole, Other		
Top of Lap Pipe or Reduction in Casing FEET IF TELESCOPED OR MORE THAN ONE SCREEN: USE BACK PAGE		

LOG DATA	
TYPE OF LOG RUN (Circle One): Electric, Gamma Ray, Density, Sonic, No Log Run , Other (Describe) _____	
Name of Organization Running Log	

SCREEN DATA		
Diameter - Inches 2"	Length - Feet 20'	Slot Size - Inches .008
Screen Type PVC	Depth to Bottom - Feet 535'	


GEOLOGIC DATA (Office Use Only)			
Surface Elev.	Geologic Unit	Unit Thickness	Depth to Top
Subs. SWL	Date	Analysis	Aquifer Test
Driller's Remarks			

DESCRIPTION OF FORMATIONS ENCOUNTERED	FROM	TO	FORMATIONS (Continued)	FROM	TO
White Coarse Sand	0	29	RECEIVED SEP 21 1987 Department of Natural Resources Bureau of Land & Water Resources	540	
Blue Clay	29	54			
White Coarse Sand	54	70			
Blue Clay	70	140			
Gray Coarse Sand	140	176			
Blue Clay	176	180			
Gray Coarse Sand	180	191			
Blue Clay	191	236			
Gray Med Sand	236	313			
Blue Clay	313	498			
Med Gray Sand	498	535			

IF MORE SPACE IS NEEDED, USE BACK

If well telescopes please sketch and show depths.


GROUND LEVEL

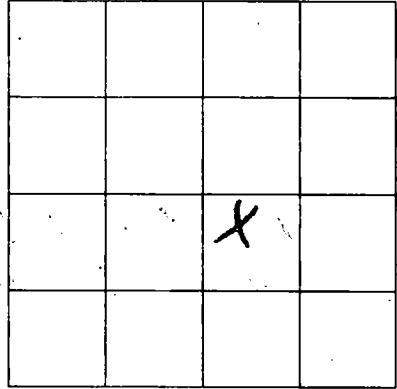

SECTION 4

Please indicate well location X.

ADDITIONAL INFORMATION

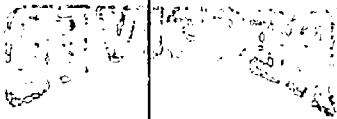

If more than one screen,
show location of each on sketch.