

MISSISSIPPI DEPARTMENT OF NATURAL RESOURCES
Bureau of Land and Water Resources

P.O. Box 10631
Jackson, Mississippi 39209
WATER WELL DRILLERS LOG

COUNTY WELL LOCATED
Jackson

WELL NUMBER CODED
Φ 2296

DATE WELL COMPLETED
6-1-87

PERMIT NUMBER

NAME OF DRILLING FIRM
Coast Water Well Service

NAME & MAILING ADDRESS OF LANDOWNER
Singing River Auto Hwy. 90 Dalton, Mo. 39553

WELL LOCATION: SEC TOWNSHIP RANGE
35 7 7

DISTANCE DIRECTION NEAREST TOWN
1N Miles of GAITHER

OTHER LANDMARK

WELL PURPOSE; Home, Irrigation, Municipal, Industrial, Fish Pond, etc.
auto parts store

PUMP DATA

PUMP TYPE (Circle One):
Submersible, Turbine, Jet Flowing Well, Other (Describe)

POWER TYPE (Circle One):
Electric, Tractor Diesel, Gasoline, Butane, Other (Describe)

Pump Capacity (GPM) No. of Stages Setting Depth
8 1 FT.

PUMP TEST
Well yielded _____ GPM with a drawdown of _____ ft. after _____ hours of pumping

WELL DATA

Well Depth <i>70'</i>	Casing Diameter (In.) <i>2"</i>	Casing Length (Ft.) <i>60'</i>
Type of Casing <i>PVC</i>	Hole Depth <i>70'</i>	Depth to Static Water Level <i>18'</i>

TYPE OF COMPLETION: (Circle One or More):
Natural Development, Gravel Packed, Underreamed, Telescoped, Open Hole, Other (Describe)

Top of Lap Pipe or Reduction in Casing

FEET IF TELESCOPED OR MORE THAN ONE SCREEN: USE BACK PAGE

LOG DATA

TYPE OF LOG RUN (Circle One):
Electric, Gamma Ray, Density, Sonic, Neutron, Other (Describe)
No Log Run

Name of Organization Running Log

SCREEN DATA

Diameter - Inches <i>2"</i>	Length - Feet <i>10'</i>	Slot Size - Inches <i>.008</i>
Screen Type <i>PVC</i>	Depth to Bottom - Feet <i>70'</i>	

GEOLOGIC DATA (Office Use Only)

Surface Elev.	Geologic Unit	Unit Thickness	Depth to Top
Subs. SWL	Date	Analysis	Aquifer Test

Driller's Remarks

DESCRIPTION OF FORMATIONS ENCOUNTERED	FROM	TO
<i>Top Soil</i>	<i>0</i>	<i>2</i>
<i>Brown Coarse Sand</i>	<i>2</i>	<i>13</i>
<i>Blue Clay</i>	<i>13</i>	<i>40</i>
<i>Gray Coarse Sand</i>	<i>40</i>	<i>70</i>

RECEIVED


SEP 21 1987

Department of Natural Resources
Bureau of Land & Water Resources

IF MORE SPACE IS NEEDED, USE BACK

If well telescopes please sketch and show depths.

GROUND LEVEL

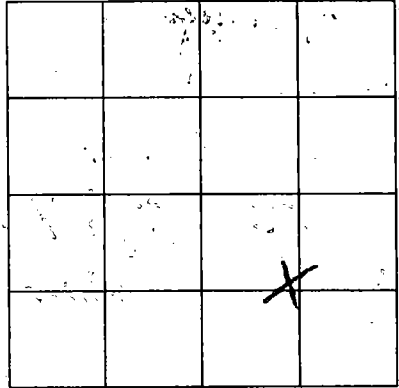

SECTION 35

Please indicate well location X.

ADDITIONAL INFORMATION

[Faint, illegible handwritten text]

[Faint, illegible handwritten text]

If more than one screen, show location of each on sketch.