

MISSISSIPPI DEPARTMENT OF NATURAL RESOURCES
Bureau of Land and Water Resources

P.O. Box 10631
Jackson, Mississippi 39209
WATER WELL DRILLERS LOG

COUNTY WELL LOCATED
Jackson
WELL NUMBER CODED
Φ9999
DATE WELL COMPLETED
6-1-87

PERMIT NUMBER
NAME OF DRILLING FIRM
Coast Water Well Sew.

NAME & MAILING ADDRESS OF LANDOWNER
T. McCallister
1909 Lamonte
Gautier, Ms. 39533
WELL LOCATION: SEC TOWNSHIP RANGE
1 8 7 W
DISTANCE DIRECTION NEAREST TOWN
1/2 Miles *—* of *GAUTIER*
OTHER LANDMARK
WELL PURPOSE (Home, Irrigation, Municipal, Industrial, Fish Pond, etc.)
Rain care

PUMP DATA

PUMP TYPE (Circle One):
Submersible, Turbine, **Jet** Flowing Well,
Other (Describe) _____
POWER TYPE (Circle One):
Electric, Tractor, Diesel, Gasoline, Butane,
Other (Describe) _____
Pump Capacity (GPM) No. of Stages Setting Depth
6 *31* *—* FT.
PUMP TEST
Well yielded _____ GPM with
a drawdown of _____ ft.
after _____ hours of pumping

WELL DATA

Well Depth <i>75'</i>	Casing Diameter (In) <i>2"</i>	Casing Length (Ft.) <i>65'</i>
Type of Casing <i>PVC</i>	Hole Depth <i>75'</i>	Depth to Static Water Level <i>18'</i>

TYPE OF COMPLETION: (Circle One or More):
Gravel Packed, Underreamed, Telescoped,
Natural Development, Open Hole, Other
(Describe) _____
Top of Lap Pipe or Reduction in Casing
FEET IF TELESCOPED OR MORE THAN ONE SCREEN: USE BACK PAGE

LOG DATA

TYPE OF LOG RUN (Circle One):
Electric, Gamma Ray, Density, Sonic, Neutron,
Other (Describe) _____
No Log Run.
Name of Organization Running Log

SCREEN DATA

Diameter - Inches <i>2"</i>	Length - Feet <i>10'</i>	Slot Size - Inches <i>.008</i>
Screen Type <i>PVC</i>	Depth to Bottom - Feet <i>75'</i>	

GEOLOGIC DATA (Office Use Only)

Surface Elev.	Geologic Unit	Unit Thickness	Depth to Top
Subs. SWL	Date	Analysis	Aquifer Test

Driller's Remarks

DESCRIPTION OF FORMATIONS ENCOUNTERED	FROM	TO
<i>Top Soil</i>	<i>0</i>	<i>2</i>
<i>Brown Coars Sand</i>	<i>2</i>	<i>13</i>
<i>Blue Clay</i>	<i>13</i>	<i>40</i>
<i>Gray Coars Sand</i>	<i>40</i>	<i>75</i>

RECEIVED


SEP 21 1987

Department of Natural Resources
Bureau of Land & Water Resources

IF MORE SPACE IS NEEDED, USE BACK

If well telescopes please sketch and show depths.

GROUND LEVEL

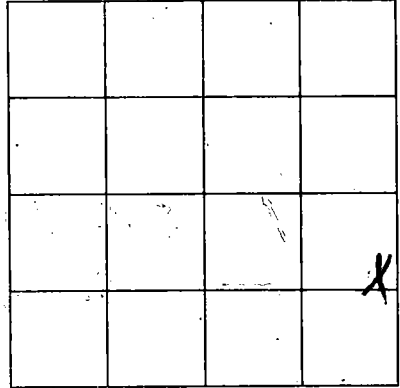

SECTION 1

Please indicate well location X.

ADDITIONAL INFORMATION

Lined area for additional information.

[Faint, illegible text]

[Faint, illegible text]

If more than one screen, show location of each on sketch.