

add ion pump
MISSISSIPPI DEPARTMENT OF NATURAL RESOURCES
 Bureau of Land and Water Resources

COUNTY WELL LOCATED
Jackson

WELL NUMBER CODED
Q2301

DATE WELL COMPLETED
1-6-88

PERMIT NUMBER

NAME OF DRILLING FIRM
Coastwater Wellser

P.O. Box 10631
 Jackson, Mississippi 39209
WATER WELL DRILLERS LOG

NAME & MAILING ADDRESS OF LANDOWNER
Point Clear
GRAVELINE Rd,
GAUTIER, Ms

WELL LOCATION: SEC TOWNSHIP RANGE
15 8 N 7 W

DISTANCE DIRECTION NEAREST TOWN
IN Miles **—** of **GAUTIER**

OTHER LANDMARK

WELL PURPOSE: Home Irrigation, Municipal, Industrial, Fish Pond, etc.
pools.

PUMP DATA *1HP motor*

PUMP TYPE (Circle One):
 Submersible, Turbine, **Jet** Flowing Well,
 Other (Describe) _____

POWER TYPE (Circle One):
Electric Tractor, Diesel, Gasoline, Butane,
 Other (Describe) _____

Pump Capacity (GPM) No. of Stages Setting Depth
16 2 40 FT.

PUMP TEST
 Well yielded _____ GPM with
 a drawdown of _____ ft.
 after _____ hours of pumping

WELL DATA

Well Depth 70'	Casing Diameter (In.) 2"	Casing Length (Ft.) 60'
Type of Casing PVC	Hole Depth 73'	Depth to Static Water Level 15'

TYPE OF COMPLETION: (Circle One or More):
 Gravel Packed, Underreamed, Telescoped,
Natural Development, Open Hole, Other

Top of Lap Pipe or Reduction in Casing
FEET IF TELESCOPED OR MORE THAN ONE SCREEN: USE BACK PAGE.

LOG DATA

TYPE OF LOG RUN (Circle One):
 Electric, Gamma Ray, Density, Sonic, **No Log Run**, Neutron,
 Other (Describe) _____

Name of Organization Running Log

SCREEN DATA

Diameter - Inches 2"	Length - Feet 10'	Slot Size - Inches 008
Screen Type PVC	Depth to Bottom - Feet 70'	

GEOLOGIC DATA (Office Use Only)

Surface Elev.	Geologic Unit	Unit Thickness	Depth to Top
Subs. SWL.	Date	Analysis	Aquifer Test

Driller's Remarks


DESCRIPTION OF FORMATIONS ENCOUNTERED	FROM	TO	FORMATIONS ENCOUNTERED	FROM	TO
white clay	0	20			
white clay w/ shreds of sand	20	35			
blue clay	35	SS			
grey coarse sand	SS	73			

RECEIVED
MAY 24 1988
 Department of Natural Resources
 Bureau of Land & Water Resources

IF MORE SPACE IS NEEDED, USE BACK

If well telescopes please sketch and show depths.

GROUND LEVEL

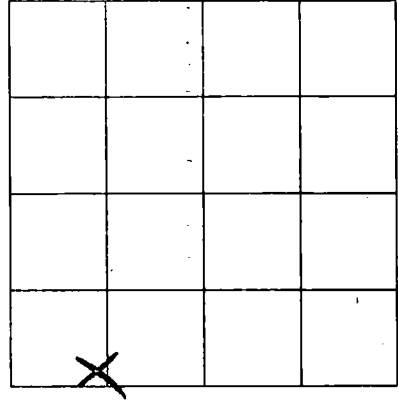

SECTION

15

Please indicate well location X.

ADDITIONAL INFORMATION

If more than one screen,
show location of each on sketch.