

MISSISSIPPI DEPARTMENT OF NATURAL RESOURCES
Bureau of Land and Water Resources

COUNTY/WELL LOCATED JACKSON	
WELL NUMBER Φ 2312	CODED
DATE WELL COMPLETED 17-3-87	

PERMIT NUMBER
NAME OF DRILLING FIRM COAST WATER
WELL SERVICE

P.O. Box 10631
Jackson, Mississippi 39209
WATER WELL DRILLERS LOG

NAME & MAILING ADDRESS OF LANDOWNER JIMMY MILLER C Byrd Rd Ocean Springs MS.			
WELL LOCATION:	SEC	TOWNSHIP	RANGE
	20	7	7
DISTANCE	DIRECTION	NEAREST TOWN	
2 Miles	NE	of Ocean Springs	
OTHER LANDMARK			
WELL PURPOSE: Home, Irrigation, Municipal, Industrial, Fish Pond, etc. home			

PUMP DATA		
PUMP TYPE (Circle One): Submersible, Turbine, Jet Flowing Well, Other (Describe) _____		
POWER TYPE (Circle One): Electric Tractor, Diesel, Gasoline, Butane, Other (Describe) _____		
Pump Capacity (GPM) 8	No. of Stages 2	Setting Depth - FT.
PUMP TEST Well yielded _____ GPM with a drawdown of _____ ft. after _____ hours of pumping		

WELL DATA		
Well Depth 390	Casing Diameter (In.) 2"	Casing Length (Ft.) 375'
Type of Casing PVC	Hole Depth 390'	Depth to Static Water Level 45'
TYPE OF COMPLETION: (Circle One or More): Gravel Packed , Underreamed, Telescoped, Natural Development , Open Hole, Other (Describe) _____		
Top of Lap Pipe or Reduction in Casing FEET IF TELESCOPED OR MORE THAN ONE SCREEN: USE BACK PAGE		

LOG DATA	
TYPE OF LOG RUN (Circle One): Electric, Gamma Ray, Density, Sonic, No Log Run , Neutron Other (Describe) _____	
Name of Organization Running Log	

SCREEN DATA		
Diameter - Inches 2"	Length - Feet 10'	Slot Size - Inches 008
Screen Type PVC	Depth to Bottom - Feet 385'	

GEOLOGIC DATA (Office Use Only)			
Surface Elev.	Geologic Unit	Unit Thickness	Depth to Top
Subs. SWL	Date	Analysis	Aquifer Test
Driller's Remarks			


RECEIVED

DESCRIPTION OF FORMATIONS ENCOUNTERED	FROM	TO	DESCRIPTIONS (Continued)	FROM	TO
TOP SOIL	0	2	MAY 24 1988 Department of Natural Resources Bureau of Land & Water Resources		
WHITE COARSE SAND	2	16			
BLUE CLAY	16	100			
FINE GRAY SAND	100	124			
BLUE CLAY	124	355			
GRAY COARSE SAND	355	390			

IF MORE SPACE IS NEEDED, USE BACK

If well telescopes please sketch and show depths.

GROUND LEVEL

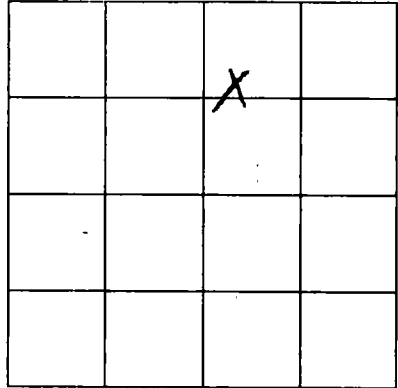

SECTION 20

Please indicate well location X.

ADDITIONAL INFORMATION

If more than one screen,
show location of each on sketch.