

MISSISSIPPI DEPARTMENT OF NATURAL RESOURCES

Bureau of Land and Water Resources

Southport Mall

P.O. Box 10631

Jackson, Mississippi 39209

WATER WELL DRILLERS LOG

JACKSON  
Q 2320

8-17-87  
 date well completed

Fry Fogle Well Servi.  
 firm name

JACKSON  
 county well located

LANDOWNER: Robert A. Lewis  
 (Bobby)  
1303 Queen Park Circle  
Ocean Springs, MS 39564  
 (mailing address)

description of formations encountered	from	to
Top Soil	0	5
" "	5	20
Clay	20	40
" "	40	60
" "	60	80
Silt	80	100
Silt & Clay	100	120
Clay	120	140
" "	140	160
" "	160	180
sand	180	191
Clay	191	200
sand	200	201
Clay	201	220
" "	220	240
" "	240	350
Silt Sand.	350	390
Fine Sand.	390	410

WELL LOCATION:  
 sec 2 T 8 N R 7 E  
4 miles South of Mount Laurel  
 (distance) (direction) (nearest town)

WELL PURPOSE:  
 (home) irrigation, municipal, industrial

WELL COMPLETION DATA:  
 (1) diameter (inches) 2"  
 (2) total depth (feet) 410'  
 (3) static water level (feet) 90  below top of ground.  
 (4) casing PVC, 400  
 (material) (depth)  
W If telescope see back.  
 (size)  
 (5) screen 5' ±  
 (length) (depth to top)  
#6, PVC  
 (size) (material)  
 (6) pump 1 (HP)          (yield gpm)  
Elect  
 (type power)  
 (7) electric log W  
 (yes or no)  
W  
 (organization running log)  
 (8) how well bottom plugged PVC  
Barbed


DRILLERS REMARKS:



Department of Natural Resources  
 Bureau of Land & Water Resources

If well telescopes please sketch and show depths.

GROUND LEVEL

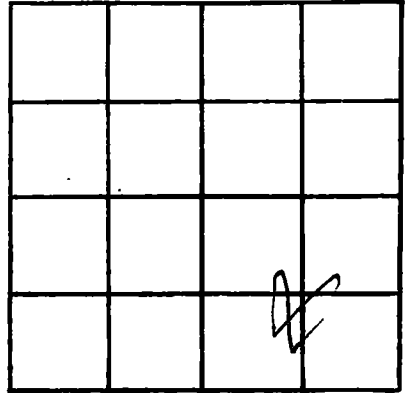

SECTION 6

Please indicate well location X.

ADDITIONAL INFORMATION

If more than one screen,  
show locations of each on sketch.