

MISSISSIPPI DEPARTMENT OF NATURAL RESOURCES
Bureau of Land and Water Resources

P.O. Box 10631

Jackson, Mississippi 39209

WATER WELL DRILLERS LOG

| | |
|--|-------|
| COUNTY WELL LOCATED Jackson | |
| WELL NUMBER 23230 | CODED |
| DATE WELL COMPLETED 10-11-88 | |

| |
|--|
| PERMIT NUMBER |
| NAME OF DRILLING FIRM Coast Water Well Service |

| | | |
|--|----------------------|----------------------|
| NAME & MAILING ADDRESS OF LANDOWNER John Davis Sr Old Spanish Trail Gautier ms 39553 | | |
| WELL LOCATION: SEC | TOWNSHIP | RANGE |
| 38 | 7^N | 7^W |
| DISTANCE | DIRECTION | NEAREST TOWN |
| 3 Miles | West | of Gautier |
| OTHER LANDMARK | | |
| WELL PURPOSE: Home, Irrigation, Municipal, Industrial, Fish Pond, etc. Home | | |

| | | |
|--|---------------------------|-------------------------------|
| PUMP DATA | | |
| PUMP TYPE (Circle One): Submersible, Turbine, Jet Flowing Well, Other (Describe) _____ | | |
| POWER TYPE (Circle One): Electric , Tractor, Diesel, Gasoline, Butane, Other (Describe) _____ | | |
| Pump Capacity (GPM) 13 | No. of Stages 2 | Setting Depth — FT. |
| PUMP TEST | | |
| Well yielded _____ GPM with a drawdown of _____ ft. after _____ hours of pumping | | |


| | | |
|---|--|---|
| WELL DATA | | |
| Well Depth 301²⁶ | Casing Diameter (In.) 2" | Casing Length (Ft.) 253' |
| Type of Casing PVC | Hole Depth 301' | Depth to Static Water Level 25' |
| TYPE OF COMPLETION: (Circle One or More): Gravel Packed, Underreamed, Telescoped, Natural Development , Open Hole, Other | | |
| Top of Lap Pipe or Reduction in Casing | | |
| FEET | IF TELESCOPED OR MORE THAN ONE SCREEN: USE BACK PAGE | |

| | |
|--|--|
| LOG DATA | |
| TYPE OF LOG RUN (Circle One): Electric, Gamma Ray, Density, Sonic, Neutron, Other (Describe) _____ | |
| No Log Run. | |
| Name of Organization Running Log | |

| | | |
|--------------------------------|---------------------------------------|-----------------------------------|
| SCREEN DATA | | |
| Diameter - Inches 2" | Length - Feet 10' | Slot Size - Inches .008 |
| Screen Type PVC | Depth to Bottom - Feet 263' | |

| | | | |
|--|---------------|----------------|--------------|
| GEOLOGIC DATA (Office Use Only) | | | |
| Surface Elev. | Geologic Unit | Unit Thickness | Depth to Top |
| Subs. SWL | Date | Analysis | Aquifer Test |


| |
|-------------------|
| Driller's Remarks |
| |
| |
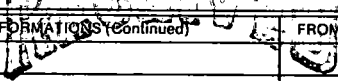
| DESCRIPTION OF FORMATIONS ENCOUNTERED | FROM | TO | FORMATIONS (continued) | FROM | TO |
|---------------------------------------|------------|------------|---|------|----|
| Top Soil | 0 | 2 |  NOV 15 1988 Department of Natural Resources Bureau of Land & Water Resources | | |
| Brown Clay | 2 | 6 | | | |
| White Coarse sand | 6 | 15 | | | |
| Blue Clay | 15 | 50 | | | |
| Gray Coarse Sand | 50 | 60 | | | |
| Blue Clay | 60 | 120 | | | |
| Gray Med sand | 120 | 158 | | | |
| Blue Clay | 158 | 250 | | | |
| Gray Med. Sand | 251 | 263 | | | |
| Blue Clay | 263 | 301 | | | |

IF MORE SPACE IS NEEDED, USE BACK

If well telescopes please sketch and show depths.

GROUND LEVEL

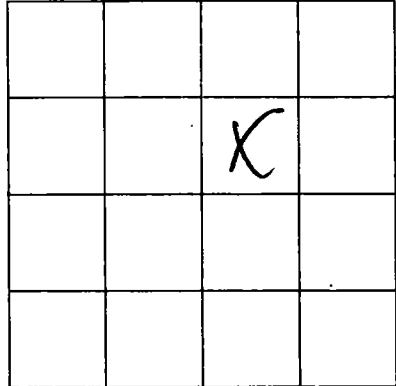

SECTION 38

Please indicate well location X.

ADDITIONAL INFORMATION

Lined area for additional information.

If more than one screen, show location of each on sketch.