

MISSISSIPPI DEPARTMENT OF NATURAL RESOURCES

Bureau of Land and Water Resources

P.O. Box 10631

Jackson, Mississippi 39209

WATER WELL DRILLERS LOG

COUNTY WELL LOCATED	
Jackson	
WELL NUMBER	CODED
02341	
DATE WELL COMPLETED	
5-9-88	

PERMIT NUMBER
NAME OF DRILLING FIRM
Coastwater Well Service

NAME & MAILING ADDRESS OF LANDOWNER			
Donald Killingsworth			
Old Shell LANDING Rd			
OCEAN SPRINGS, Ms.			
WELL LOCATION:	SEC	TOWNSHIP	RANGE
	4	8 ^N S	7 ^E W
DISTANCE	DIRECTION	NEAREST TOWN	
5	E	OCEAN SPRINGS	
OTHER LANDMARK			
WELL PURPOSE: Home, Irrigation, Municipal, Industrial, Fish Pond, etc.			
home			

PUMP DATA		
PUMP TYPE (Circle One):		
Submersible,	Turbine,	<u>Jet</u> Flowing Well,
Other (Describe) _____		
POWER TYPE (Circle One):		
<u>Electric</u> ,	Tractor,	Diesel, Gasoline, Butane,
Other (Describe) _____		
Pump Capacity (GPM)	No. of Stages	Setting Depth
9	1	_____ FT.
PUMP TEST		
Well yielded _____ GPM with		
a drawdown of _____ ft.		
after _____ hours of pumping		

WELL DATA		
Well Depth	Casing Diameter (In.)	Casing Length (Ft.)
70'	2"	60'
Type of Casing	Hole Depth	Depth to Static Water Level
PVC	70'	19'
TYPE OF COMPLETION: (Circle One or More):		
<u>Natural Development,</u>	Underreamed,	Telescoped,
(Describe)	Open Hole,	Other
Top of Lap Pipe or Reduction in Casing		
FEET	IF TELESCOPED OR MORE THAN ONE SCREEN: USE BACK PAGE	

LOG DATA	
TYPE OF LOG RUN (Circle One):	
Electric, Gamma Ray, Density, Sonic,	<u>No Log Run,</u> Neutron,
Other (Describe) _____	
Name of Organization Running Log	

SCREEN DATA		
Diameter - Inches	Length - Feet	Slot Size - Inches
2"	10'	008
Screen Type	Depth to Bottom - Feet	
PVC	70'	

GEOLOGIC DATA (Office Use Only)			
Surface Elev.	Geologic Unit	Unit Thickness	Depth to Top
Subs. SWL	Date	Analysis	Aquifer Test

Driller's Remarks


DESCRIPTION OF FORMATIONS ENCOUNTERED	FROM	TO
Brown Med Sand	0	25
Blue Clay	25	35
Grey Coarse Sand	35	40
Blue Clay w/ streaks of clam shell	40	55
Grey Coarse Sand.	55	70

FORMATIONS (Continued)	FROM	TO
RECEIVED		
NOV 17 1988		
Department of Natural Resources Bureau of Land & Water Resources		

IF MORE SPACE IS NEEDED, USE BACK

If well telescopes please sketch and show depths.

GROUND LEVEL

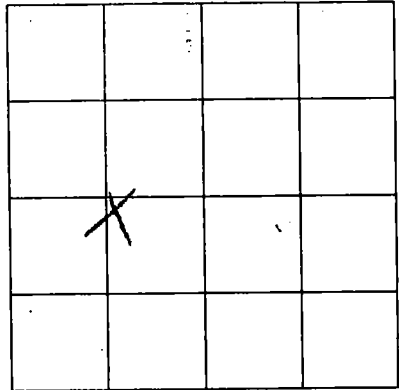

SECTION

4

Please indicate well location X.

ADDITIONAL INFORMATION

If more than one screen,
show location of each on sketch.