

MISSISSIPPI DEPARTMENT OF NATURAL RESOURCES

Bureau of Land and Water Resources

Southport Mall

P.O. Box 10631

Jackson, Mississippi 39209

WATER WELL DRILLERS LOG


Jackson
 \$2355

11-1-89 19 Southern Water Well Jackson
 date well completed firm name county well located

LANDOWNER:	description of formations encountered	from	to
<u>W A Davis</u>	<u>Sand</u>	<u>0</u>	<u>5</u>
<u>Av De La Charmain Route</u> (mailing address) <u>MS</u>	<u>clay Sand</u>	<u>5</u>	<u>20</u>
WELL LOCATION: sec <u>24</u> T <u>7</u> N R <u>7</u> E <u>city of Gautier</u> (distance) (direction) (nearest town)			
WELL PURPOSE: <u>Municipal</u> (home, irrigation, municipal, industrial)			
WELL COMPLETION DATA:			
(1) diameter (inches) <u>2"</u>			
(2) total depth (feet) <u>35'</u>			
(3) static water level (feet) <u>4</u> ^(below) above top of ground.			
(4) casing <u>PK</u> <u>30'</u> (material) (depth)			
(size) If telescope see back.			
(5) screen <u>5'</u> <u>30'</u> (length) (depth to top)			
<u>2"</u> <u>PVC</u> (size) (material)			
(6) pump <u>None</u> (HP) (yield gpm)			
(type power)			
(7) electric log (yes or no)			
(organization running log)			
(8) how well bottom plugged <u>Good</u>			
DRILLERS REMARKS:			

**if well telescopes please
sketch and show depths.**

GROUND LEVEL

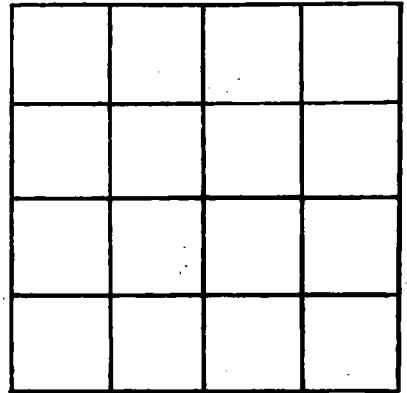

SECTION _____

Please indicate well location X.

ADDITIONAL INFORMATION

**If more than one screen,
show locations of each on sketch.**