


**MISSISSIPPI DEPARTMENT OF NATURAL RESOURCES**  
**Bureau of Land and Water Resources**  
 Southport Mall  
 P.O. Box 10631  
 Jackson, Mississippi 39209  
**WATER WELL DRILLERS LOG**

Jackson  
Φ 2356

1/1/89 19 Southern Water Well Jackson  
 date well completed firm name county well located

LANDOWNER:	description of formations encountered	from	to
<u>W. Morie</u>			
<u>Ruleda Lorraine Baultier</u> (mailing address) <u>MS</u>	<u>Clay Sand</u>	<u>5</u>	<u>20</u>
<u>20</u>		<u>20</u>	<u>35</u>
<b>WELL LOCATION:</b>			
sec <u>24</u> T <u>7</u> N R <u>7</u> E			
City of <u>Sauter</u>			
(distance) (direction) of (nearest town)			
<b>WELL PURPOSE:</b> <u>irrigation</u> (home, irrigation, municipal, industrial)			
<b>WELL COMPLETION DATA:</b>			
(1) diameter (inches) <u>2"</u>			
(2) total depth (feet) <u>35</u>			
(3) static water level (feet) <u>4</u> <u>below</u> above top of ground			
(4) casing <u>PVC 30'</u> (material) (depth)			
(size) if telescope see back.			
(5) screen <u>5'</u> <u>30'</u> (length) (depth to top)			
<u>2"</u> <u>PVC</u> (size) (material)			
(6) pump <u>none</u> (HP) (yield gpm)			
(type power)			
(7) electric log <u>yes or no</u>			
(organization running log)			
(8) how well bottom plugged <u>BAW</u>			

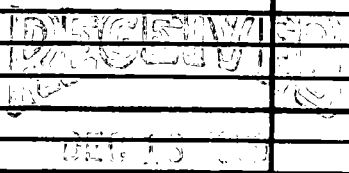


Department of Natural Resources  
 Bureau of Land & Water Resources

**DRILLERS REMARKS:**

If well telescopes please sketch and show depths.

GROUND LEVEL

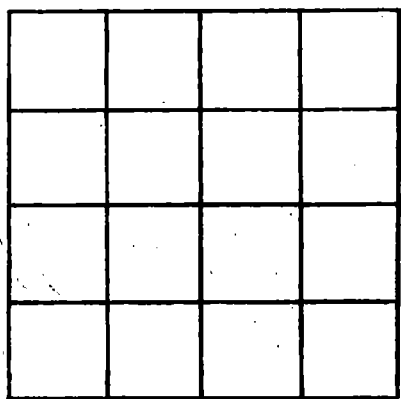

SECTION \_\_\_\_\_

Please indicate well location X.

**ADDITIONAL INFORMATION**

A series of 20 horizontal lines provided for entering additional information.

If more than one screen, show locations of each on sketch.