

MISSISSIPPI DEPARTMENT OF NATURAL RESOURCES

Bureau of Land and Water Resources

Southport Mall

P.O. Box 10631

Jackson, Mississippi 39209

WATER WELL DRILLERS LOG

Jackson
 02308

4/24/90

date well completed

19 Southern Well Service

firm name

Jackson

county well located

LANDOWNER:

Billy Bush

ORA Hollow

Dauter m

(mailing address)

description of formations encountered

from

to

clay
 sandy clay
 clay

0 15
 15 45
 45 60

WELL LOCATION:

sec. 21 T 7 N R 2 E

City of Dauter

(distance) miles (direction) of (nearest town)

RECEIVED

MAY 9 1990

WELL PURPOSE:

irrigation

(home, irrigation, municipal, industrial)

Department of Natural Resources
 Bureau of Land & Water Resources


WELL COMPLETION DATA:

- (1) diameter (inches) 2"
- (2) total depth (feet) 60'
- (3) static water level (feet) 8' below
top of ground above
- (4) casing PVC 55'
(material) (depth)
- (size) If telescope see back.
- (5) screen 5' 55'
(length) (depth to top)
- 2" PVC
(size) (material)
- (6) pump 1 (HP) 12 (yield gpm)
- pc
(type power)
- (7) electric log N/A
(yes or no)
- all
(organization running log)
- (8) how well bottom plugged BWV

DRILLERS REMARKS:

If well telescopes please sketch and show depths.

GROUND LEVEL

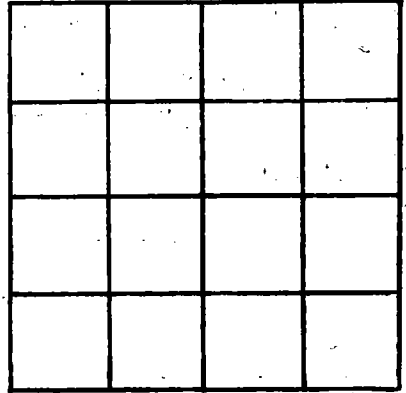

SECTION _____

Please indicate well location X.

ADDITIONAL INFORMATION

If more than one screen,
show locations of each on sketch.