

MISSISSIPPI DEPARTMENT OF NATURAL RESOURCES

Bureau of Land and Water Resources

Southport Mall

P.O. Box 10631

Jackson, Mississippi 39209

Post Office Box 188

WATER WELL DRILLERS LOG

Hurley, MS 39555

Phone 588-256

JACKSON
#7371

7-24-90
date well completed

firm name

Jackson
county well located

LANDOWNER:

J. Rozenka
Sing St
Bautier
(mailing address)

description of formations encountered

from

to

sand	0	20
clay	20	45
sand	45	65

WELL LOCATION:

sec 24 T 7 N R 7 E
City of Bautier
(distance) (direction) (nearest town)

WELL PURPOSE:

(home, irrigation, municipal, industrial)

WELL COMPLETION DATA:

- (1) diameter (inches) 2"
- (2) total depth (feet) 65'
- (3) static water level (feet) 15 below above top of ground.
- (4) casing PVC, 60'
(material) (depth)
(size) If telescope see back.
- (5) screen 5', 60'
(length) (depth to top)
2", PVC
(size) (material)
- (6) pump 1/2 10
(HP) (yield gpm)
AC
(type power)
- (7) electric log _____
(yes or no)
(organization running log)
- (8) how well bottom plugged good

RECEIVED


AUG 29 1990

Department of Natural Resources
Bureau of Land & Water Resources

DRILLERS REMARKS:

If well telescopes please sketch and show depths.

GROUND LEVEL

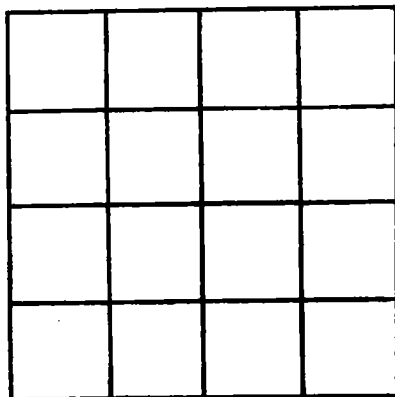

SECTION _____

Please indicate well location X.

ADDITIONAL INFORMATION

If more than one screen, show locations of each on sketch.