

**MISSISSIPPI DEPARTMENT OF ENVIRONMENTAL QUALITY**  
Bureau of Land and Water Resources

P. O. Box 10631  
Jackson, MS 39289-0631  
**WATER WELL DRILLERS LOG**

COUNTY WELL LOCATED <i>Jackson</i>	
WELL NUMBER <del>2382</del> <i>2382</i>	CODED
DATE WELL COMPLETED <i>2-13-92</i>	

PERMIT NUMBER
NAME OF DRILLING FIRM <i>Coast Water Well, Inc.</i>

NAME & MAILING ADDRESS OF LANDOWNER <i>Cliff Flurry</i>			
WELL LOCATION: SEC <u>6</u> TOWNSHIP <u>7<sup>N</sup></u> RANGE <u>7<sup>E</sup></u>			
DISTANCE <u>4</u> Miles	DIRECTION <u>North</u>	NEAREST TOWN <u>Fountain Bluff</u>	
OTHER LANDMARK			
WELL PURPOSE <input checked="" type="checkbox"/> Home Irrigation, <input type="checkbox"/> Municipal, <input type="checkbox"/> Industrial, <input type="checkbox"/> Fish Pond, etc.			

<b>PUMP DATA</b>		
PUMP TYPE (Circle One): Submersible, Turbine, <input checked="" type="radio"/> Jet, Flowing Well, Other (Describe) _____		
POWER TYPE (Circle One): <input checked="" type="radio"/> Electric, Tractor, Diesel, Gasoline, Butane, Other (Describe) _____ H/P <u>1hp</u>		
Pump Capacity (GPM)	No. of Stages	Setting Depth _____ FT.
PUMP TEST		
Well yielded _____ GPM with a drawdown of _____ ft. after _____ hours of pumping		

<b>WELL DATA</b>		
Well Depth <u>322'</u>	Casing Diameter (In.) <u>2"</u>	Casing Length (Ft.) <u>306'</u>
Type of Casing <u>PVC</u>	Hole Depth <u>322</u>	Depth to Static Water Level <u>45'</u>
TYPE OF COMPLETION: (Circle One or More): <input type="checkbox"/> Gravel Packed, <input type="checkbox"/> Underreamed, <input type="checkbox"/> Telescoped, <input type="checkbox"/> Natural Development, <input type="checkbox"/> Open Hole, <input type="checkbox"/> Other (Describe) _____		
Top of Lap Pipe or Reduction in Casing		
FEET IF TELESCOPED OR MORE THAN ONE SCREEN: USE BACK PAGE		

<b>LOG DATA</b>	
TYPE OF LOG RUN (Circle One): Electric, Gamma Ray, Density, Sonic, Neutron, Other (Describe) _____ <input checked="" type="radio"/> No Log Run	
Name of Organization Running Log	

<b>SCREEN DATA</b>		
Diameter - Inches <u>2"</u>	Length - Feet <u>10'</u>	Slot Size - Inches <u>.008</u>
Screen Type <u>PVC</u>	Depth to Bottom - Feet <u>316</u>	

<b>GEOLOGIC DATA (Office Use Only)</b>			
Surface Elev.	Geologic Unit	Unit Thickness	Depth to Top
Subs. SWL	Date	Analysis	Aquifer Test
Driller's Remarks			

DESCRIPTION OF FORMATIONS ENCOUNTERED	FROM	TO	FORMATIONS (Continued)	FROM	TO
<i>top soil</i>	<i>0</i>	<i>2</i>			
<i>gray clay</i>	<i>2</i>	<i>12</i>			
<i>fine sand</i>	<i>12</i>	<i>18</i>			
<i>blue clay</i>	<i>18</i>	<i>30</i>			
<i>coarse sand</i>	<i>30</i>	<i>90</i>			
<i>blue clay</i>	<i>90</i>	<i>135</i>			
<i>fine sand</i>	<i>135</i>	<i>150</i>			
<i>coarse sand</i>	<i>150</i>	<i>174</i>			
<i>blue clay</i>	<i>174</i>	<i>295</i>			
<i>coarse sand</i>	<i>295</i>	<i>316</i>			
<i>blue clay</i>	<i>316</i>	<i>322</i>			

**RECEIVED**


MAR 23 1992

Dept. of Environmental Quality  
Bureau of Land & Water Resources

IF MORE SPACE IS NEEDED, USE BACK

If well telescopes please sketch and show depths.

GROUND LEVEL

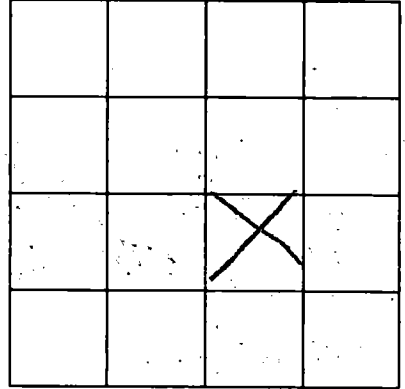

SECTION \_\_\_\_\_

Please indicate well location X.

ADDITIONAL INFORMATION

Lined area for additional information.

If more than one screen, show location of each on sketch.