

**MISSISSIPPI DEPARTMENT OF NATURAL RESOURCES**  
Bureau of Land and Water Resources

P.O. Box 10631  
Jackson, Mississippi 39209  
**WATER WELL DRILLERS LOG**

COUNTY WELL LOCATED <i>Jackson</i>	WELL NUMBER <i>Φ 283</i>	CODED
DATE WELL COMPLETED <i>3-5-92</i>		

PERMIT NUMBER
NAME OF DRILLING FIRM <i>Pierce Drilling</i>

NAME & MAILING ADDRESS OF LANDOWNER <i>Johnny Narmore</i>			
ADDRESS <i>Hurley, Ms.</i>			
WELL LOCATION	SEC	TOWNSHIP	RANGE
	<i>7</i>	<i>8</i>	<i>7</i>
DISTANCE	DIRECTION	NEAREST TOWN	
<i>1/4</i> Miles	<i>S</i>	<i>Traveline Bayou</i>	
OTHER LANDMARK			
WELL PURPOSE: <input checked="" type="checkbox"/> Home, <input type="checkbox"/> Irrigation, <input type="checkbox"/> Municipal, <input type="checkbox"/> Industrial, <input type="checkbox"/> Fish Pond, etc.			

PUMP DATA		
PUMP TYPE (Circle One): Submersible, Turbine, <input checked="" type="checkbox"/> <b>Jet</b> , Flowing Well, Other (Describe) _____		
POWER TYPE (Circle One): <input checked="" type="checkbox"/> <b>Electric</b> , Tractor, Diesel, Gasoline, Butane, Other (Describe) _____		
Pump Capacity (GPM)	No. of Stages	Setting Depth
<i>10</i>	<i>2</i>	<i>60</i> FT.
PUMP TEST		
Well yielded <i>10</i> GPM with a drawdown of <i>10</i> ft. after <i>1</i> hours of pumping		

WELL DATA		
Well Depth <i>160'</i>	Casing Diameter (In.) <i>2"</i>	Casing Length (Ft.) <i>150'</i>
Type of Casing <i>Plastic</i>	Hole Depth <i>160'</i>	Depth to Static Water Level <i>20'</i>
TYPE OF COMPLETION: (Circle One or More): <input checked="" type="checkbox"/> <b>Natural Development</b> , <input type="checkbox"/> Gravel Packed, <input type="checkbox"/> Underreamed, <input type="checkbox"/> Telescoped, <input type="checkbox"/> Open Hole, <input type="checkbox"/> Other		
Top of Lap Pipe or Reduction in Casing <i>0 - FEET</i>		
IF TELESCOPED OR MORE THAN ONE SCREEN: USE BACK PAGE		

LOG DATA	
TYPE OF LOG RUN (Circle One): <input checked="" type="checkbox"/> <b>No Log Run</b> , <input type="checkbox"/> Electric, <input type="checkbox"/> Gamma Ray, <input type="checkbox"/> Density, <input type="checkbox"/> Sonic, <input type="checkbox"/> Neutron, Other (Describe) _____	
Name of Organization Running Log	

SCREEN DATA		
Diameter - Inches <i>2"</i>	Length - Feet <i>10'</i>	Slot Size - Inches <i>006</i>
Screen Type <i>Plastic</i>	Depth to Bottom - Feet <i>160'</i>	

GEOLOGIC DATA (Office Use Only)			
Surface Elev.	Geologic Unit	Unit Thickness	Depth to Top
Subs. SWL	Date	Analysis	Aquifer Test
Driller's Remarks			


DESCRIPTION OF FORMATIONS ENCOUNTERED	FROM	TO	FORMATIONS (Continued)	FROM	TO
<i>Top Soil</i>	<i>0</i>	<i>10</i>	<b>RECEIVED</b>  APR 23 1992		
<i>Clay</i>	<i>10</i>	<i>20</i>			
<i>Sand &amp; Clay</i>	<i>20</i>	<i>60</i>			
<i>Clay</i>	<i>60</i>	<i>140</i>			
<i>Good Sand</i>	<i>140</i>	<i>160</i>			

Dept. of Environmental Quality  
Bureau of Land & Water Resources

IF MORE SPACE IS NEEDED, USE BACK

If well telescopes please sketch and show depths.

GROUND LEVEL

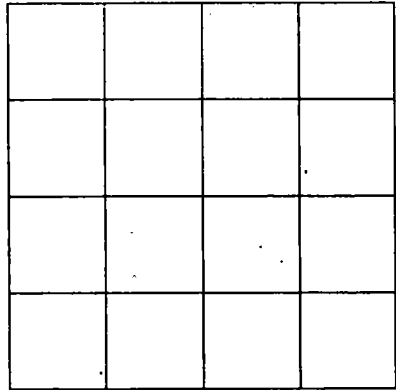

SECTION \_\_\_\_\_

Please indicate well location X.

ADDITIONAL INFORMATION

If more than one screen,  
show location of each on sketch.