

**MISSISSIPPI DEPARTMENT OF ENVIRONMENTAL QUALITY**  
Bureau of Land and Water Resources

P. O. Box 10631

Jackson, MS 39289-0631

**WATER WELL DRILLERS LOG**

COUNTY WELL LOCATED <i>Jackson</i>	
WELL NUMBER <i>2381</i>	CODED
DATE WELL COMPLETED <i>3-13-92</i>	

PERMIT NUMBER
NAME OF DRILLING FIRM <i>Coast Water Well Dr. Inc.</i>

NAME & MAILING ADDRESS OF LANDOWNER <i>C.E. Wells</i>		
WELL LOCATION: SEC <i>31</i> TOWNSHIP <i>7<sup>N</sup></i> RANGE <i>7<sup>W</sup></i>		
DISTANCE _____ Miles	DIRECTION _____	NEAREST TOWN <i>Fountainbleau</i>
OTHER LANDMARK		
WELL PURPOSE: <i>Home</i> Irrigation, Municipal, Industrial, Fish Pond, etc.		

<b>PUMP DATA</b>		
PUMP TYPE (Circle One): Submersible, Turbine, Jet, Flowing Well, Other (Describe) _____		
POWER TYPE (Circle One): Electric, Tractor, Diesel, Gasoline, Butane, Other (Describe) _____ <i>H/P</i>		
Pump Capacity (GPM)	No. of Stages	Setting Depth _____ FT.
PUMP TEST		
Well yielded _____ GPM with a drawdown of _____ ft. after _____ hours of pumping		

<b>WELL DATA</b>		
Well Depth <i>536'</i>	Casing Diameter (In.) <i>2"</i>	Casing Length (Ft.) <i>526'</i>
Type of Casing <i>PVC</i>	Hole Depth <i>536'</i>	Depth to Static Water Level <i>751</i>
TYPE OF COMPLETION: (Circle One or More): Gravel Packed, Underreamed, Telescoped, <i>Natural Development</i> , Open Hole, Other		
Top of Lap Pipe or Reduction in Casing  <b>FEET</b> IF TELESCOPED OR MORE THAN ONE SCREEN: USE BACK PAGE		

<b>LOG DATA</b>			
TYPE OF LOG RUN (Circle One): Electric, Gamma Ray, Density, <i>Sonic</i> , Neutron, Other (Describe) _____ No Log Run			
Name of Organization Running Log			
<b>RECEIVED</b>			
Surface Elev. _____	Geologic Unit _____	Unit Thickness _____	_____ to Top
Subs. SWL _____	Date <i>OCT 07 1992</i>	Analysis _____	Aquifer Test _____

<b>SCREEN DATA</b>		
Diameter - Inches <i>2"</i>	Length - Feet <i>10'</i>	Slot Size - Inches <i>.008</i>
Screen Type <i>PVC</i>	Depth to Bottom - Feet <i>536'</i>	


Driller's Remarks	
<b>Dept. of Environmental Quality</b> <b>Bureau of Land &amp; Water Resources</b>	

DESCRIPTION OF FORMATIONS ENCOUNTERED	FROM	TO	FORMATIONS (Continued)	FROM	TO
<i>top soil</i>	<i>0</i>	<i>22</i>	<i>Coarse sands of clay</i>	<i>355</i>	<i>370</i>
<i>yellow clay shale</i>	<i>2</i>	<i>15</i>	<i>Blue Clay s of sand</i>	<i>370</i>	<i>430</i>
<i>med. sand + frag</i>	<i>15</i>	<i>25</i>	<i>Coarse sand</i>	<i>430</i>	<i>441</i>
<i>Blue Clay + shell</i>	<i>25</i>	<i>55</i>	<i>Blue Clay</i>	<i>441</i>	<i>480</i>
<i>Coarse sand + shell</i>	<i>55</i>	<i>70</i>	<i>Coarse sand</i>	<i>480</i>	<i>536</i>
<i>Blue Clay</i>	<i>70</i>	<i>110</i>			
<i>med. sand</i>	<i>110</i>	<i>136</i>			
<i>Blue Clay s of sand</i>	<i>136</i>	<i>260</i>			
<i>fine to coarse sand</i>	<i>260</i>	<i>290</i>			
<i>Blue Clay s of sand</i>	<i>290</i>	<i>340</i>			
<i>fine sand</i>	<i>340</i>	<i>355</i>			

IF MORE SPACE IS NEEDED, USE BACK

If well telescopes please sketch and show depths.

GROUND LEVEL

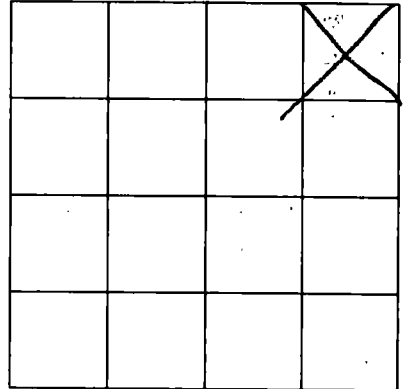

SECTION \_\_\_\_\_

Please indicate well location X.

ADDITIONAL INFORMATION

RECEIVED

U.S. DEPARTMENT OF THE INTERIOR  
BUREAU OF LAND MANAGEMENT

If more than one screen,  
show location of each on sketch.