

If well telescopes please sketch and show depths.


GROUND LEVEL

			X

SECTION 32

Please indicate well location X \ /

ADDITIONAL INFORMATION

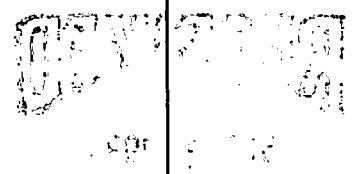

Faint, illegible text at the bottom left of the page.

If more than one screen, show location of each on sketch.