

MISSISSIPPI DEPARTMENT OF ENVIRONMENTAL QUALITY

Office of Land and Water Resources

P. O. Box 10631
Jackson, MS 39289-0631
WATER WELL DRILLERS LOG

COUNTY WELL LOCATED Jackson	
WELL NUMBER EP 2929	CODED
DATE WELL COMPLETED 11-4-94	

PERMIT NUMBER
NAME OF DRILLER (FIRM) Coast Water Well Service

NAME & MAILING ADDRESS OF LANDOWNER F.C. Byrd Construction			
Bellefontaine Beach Unit			
Ocean Springs Ms			
WELL LOCATION	SEC	TOWNSHIP	RANGE
	18	8	7
DISTANCE	DIRECTION	NEAREST TOWN	
4 Miles	SE	Ocean Springs	
OTHER LANDMARK			
WELL PURPOSE <input checked="" type="radio"/> Home Irrigation, Municipal, Industrial, Fish Pond, etc.			

PUMP DATA		
PUMP TYPE (Circle One): Submersible, Turbine, <input checked="" type="radio"/> Set Flowing Well, Other (Describe) _____		
POWER TYPE (Circle One): <input checked="" type="radio"/> Electric Tractor, Diesel, Gasoline, Butane, Other (Describe) _____ H/P 1		
Pump Capacity (GPM) 11	No. of Stages 2	Setting Depth _____ FT.
PUMP TEST		
Well yielded _____ GPM with a drawdown of _____ ft. after _____ hours of pumping		

WELL DATA

Well Depth 625'	Casing Diameter (In.) 5"	Casing Length (Ft.) 615'
Type of Casing PVC	Hole Depth 625'	Depth to Static Water Level 45'

TYPE OF COMPLETION: (Circle One or More):
 Gravel Packed, Underreamed, Telescoped,
 Natural Development, Open Hole, Other
 (Describe) _____

WELL GROUTED TO A DEPTH OF **20** FEET
 Type Grout (circle one): Cement, Bentonite, or Mix

SCREEN DATA

Diameter - Inches 2"	Length - Feet 10'	Slot Size - Inches .008
Screen Type PVC	Depth to Bottom - Feet 625'	

LOG DATA

TYPE OF LOG RUN (Circle One): **No Log Run**,
 Electric, Gamma Ray, Density, Sonic, Neutron,
 Other (Describe) _____

Name of Organization Running Log _____

GEOLOGIC DATA (Office Use Only)

Surface Elev.	Geologic Unit	Unit Thickness	Depth to Top
Subs. SWL	Date	Analysis	Aquifer Test

Driller's Remarks

Top of Lap Pipe or Reduction in Casing

FEET IF TELESCOPED OR MORE THAN ONE SCREEN: USE BACK PAGE


DESCRIPTION OF FORMATIONS ENCOUNTERED	FROM	TO	FORMATIONS (Continued)	FROM	TO
Sand	0	12	RECEIVED DEC 16 1994		
Blue Clay Shale and silt	12	60			
Coarse Sand & Peagrad	60	125			
Blue Clay Shale of sand	125	196			
Medium sand	196	220			
Blue clay Shale of sand	220	445			
Fine-Medium sand	445	455			
Blue Clay	455	580			
Medium-Coarse sand	580	625			

IF MORE SPACE IS NEEDED USE BACK

Dept. of Environmental Quality
Office of Land & Water Resources

If well telescopes please sketch and show depths.

GROUND LEVEL

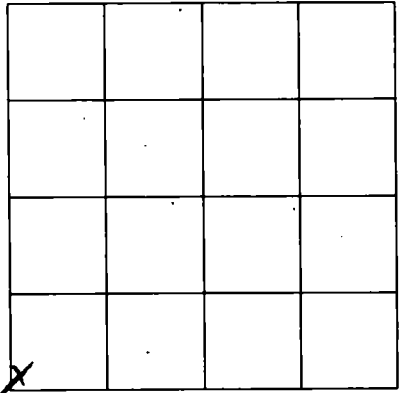

SECTION 18

Please indicate well location X.

ADDITIONAL INFORMATION

Lined area for additional information.

DEPARTMENT OF
WATER RESOURCES

WATER RESOURCES

Division of Water Resources
1000 North 1st Street, Phoenix, Arizona 85004

If more than one screen,
show location of each on sketch.