

MISSISSIPPI DEPARTMENT OF NATURAL RESOURCES

Bureau of Land and Water Resources

Southport Mall

P.O. Box 10631

Jackson, Mississippi 39209

WATER WELL DRILLERS LOG

Jackson  
2431

8-16

date well completed

1984 Coast Water Well Sew.

firm name

Jackson

county well located

LANDOWNER: R.D. Hatch

5110 Court House Rd.

Gulfport, Miss.  
(mailing address) 39501

WELL LOCATION:

sec. 18 T 8 N R 7 E  
6 miles SE of Ocean Springs  
(distance) (direction) (nearest town)

WELL PURPOSE: Home  
(home, irrigation, municipal, industrial)

WELL COMPLETION DATA:

- (1) diameter (inches) 2"
- (2) total depth (feet) 540'
- (3) static water level (feet) 35' <sup>below</sup> top of ground.
- (4) casing PVC 515' (material) (depth)  
2" (size) If telescope see back.
- (5) screen 20' 515' (length) (depth to top)  
2" PVC (size) (material)
- (6) pump 1 10 (HP) (yield gpm)  
elec (type power)
- (7) electric log No (yes or no)  
(organization running log)

(8) how well bottom plugged  
Backwash valve

DRILLERS REMARKS:

description of formations encountered

from

to

Sandy Top Soil	0	7
Blue Clay	7	25
Coarse Sand	25	40
Blue Clay	40	90
Coarse Sand	90	100
Blue Clay	100	198
Med. Sand	198	224
Blue Clay	224	400
Med. Sand	400	430
Blue Clay	430	505
Med Sand	505	540


5' x 2" PVC Tail Pipe

DEPT. OF NATURAL RESOURCES  
BUREAU OF LAND & WATER RESOURCES

RECEIVED  
OCT 15 1984

If well telescopes please sketch and show depths.

GROUND LEVEL

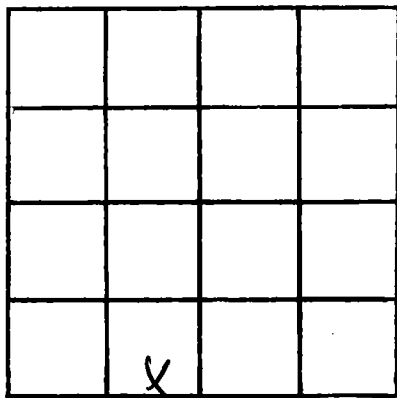

SECTION 18

Please indicate well location X.

ADDITIONAL INFORMATION

If more than one screen, show locations of each on sketch.