

MISSISSIPPI DEPARTMENT OF NATURAL RESOURCES

Bureau of Land and Water Resources

Southport Mall

P.O. Box 10631

Jackson, Mississippi 39209

WATER WELL DRILLERS LOG

Jackson
0
2432

9-21-84 19 Coas & Water Well Sew Jackson
date well completed firm name county well located

LANDOWNER:	description of formations encountered	from	to
Clair R. Stauder	Top soil	0	5'
5419 Gregory Ave Mass Point, Miss. (mailing address) 39563	Brown Mch. kind of wood	5'	68'
WELL LOCATION: sec. 19 T 8 N R 7 E 4 miles SW of Canton (distance) (direction) (nearest town)	Gray coarse sand	68'	82'
WELL PURPOSE: Home (home, irrigation, municipal, industrial)	Gray coarse sand & gravel	82'	110'
WELL COMPLETION DATA: (1) diameter (inches) 2" (2) total depth (feet) 394' (3) static water level (feet) 42' below top of ground. (4) casing PVC 384' (material) (depth) 3" (size) if telescope see back. (5) screen 10' (length) 384' (depth to top) 2" (size) PVC (material) (6) pump 1 h.p. 10 (HP) (yield gpm) Elex (type power) (7) electric log No (yes or no) (8) how well bottom plugged	Blue Clay	110'	175'
	Blue Clay & Shale sand	175'	270'
	Blue Clay	270'	305'
	Blue Clay & Shale sand	305'	327'
	Blue Clay	327'	360'
	Gray coarse sand	360'	384'
	Blue Clay	384'	394'
(organization running log)			
Backwash valve			

DEPT. OF NATURAL RESOURCES
BUREAU OF LAND & WATER RESOURCES


OCT 18 1984

RECEIVED

DRILLERS REMARKS:

If well telescopes please sketch and show depths.

GROUND LEVEL

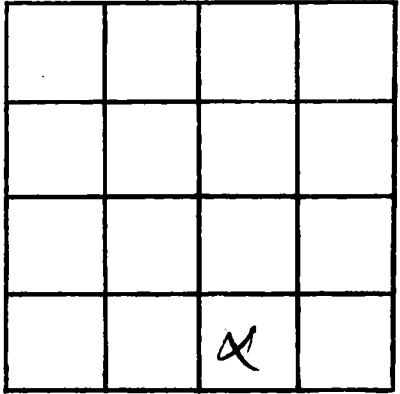

SECTION 19

Please indicate well location X.

ADDITIONAL INFORMATION

If more than one screen, show locations of each on sketch.