

JACKSON
 &
 2436

MISSISSIPPI DEPARTMENT OF NATURAL RESOURCES
 Bureau of Land and Water Resources
 Southport Mall
 P.O. Box 10631
 Jackson, Mississippi 39209
WATER WELL DRILLERS LOG

3-4-85 19 Coast Water Well Serv. Jackson.
 date well completed firm name county well located

LANDOWNER: John Hendley
3024 Ridgell Rd
Granby Miss. 39564
 (mailing address)

description of formations encountered	from	to
<u>sand (strip clay)</u>	<u>0</u>	<u>115'</u>
<u>Blue Clay (strip sand)</u>	<u>115'</u>	<u>210'</u>
<u>Blue Clay</u>	<u>210'</u>	<u>380'</u>
<u>Blue Clay w/ shell</u>	<u>380'</u>	<u>435'</u>
<u>Med Pepper sand</u>	<u>435'</u>	<u>456'</u>
<u>5" - 2" Tail Pipe</u>		

WELL LOCATION:
 sec. 18 T. 8 N. R. 7 W.
5 1/2 miles SE of Ocean Springs
 (distance) (direction) (nearest town)

WELL PURPOSE: Home -
 (home, irrigation, municipal, industrial)

- WELL COMPLETION DATA:
- diameter (inches) 2"
 - total depth (feet) 456'
 - static water level (feet) 45' below above top of ground.
 - casing PVC, 436'
 (material) (depth)
2" if telescope see back.
 (size)
 - screen 20', 436'
 (length) (depth to top)
2", PVC
 (size) (material)
 - pump 1 h.p.,
 (HP) (yield gpm)
Clear
 (type power)
 - electric log No
 (yes or no)
 (organization running log)

(8) how well bottom plugged
Backwash Valve


DRILLERS REMARKS:

RECEIVED
 JUL 10 1985

Department of Natural Resources
 Bureau of Land & Water Resources

If well telescopes please sketch and show depths.

GROUND LEVEL

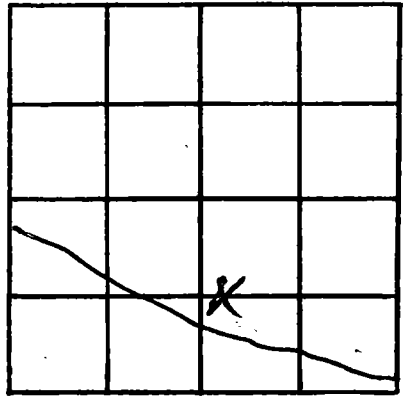

SECTION 18

Please indicate well location X.

ADDITIONAL INFORMATION

If more than one screen, show locations of each on sketch.