

MISSISSIPPI DEPARTMENT OF NATURAL RESOURCES

Bureau of Land and Water Resources

Southport Mall

P.O. Box 10631

Jackson, Mississippi 39209

WATER WELL DRILLERS LOG

JACKSON

Q

2437

4-1-85
date well completed

19

Coast Water Well Sew. Jackson
firm name county well located

LANDOWNER

Ed Turner

description of formations encountered

from to

902 Seaside Way

Top soil

0 3'

Stone Mountain, Ga.
(mailing address) 30083

Black sand

3' 18'

WELL LOCATION:

sec 19 T. 8 N R 7 E
S W
4 miles SW of GAETTER
(distance) (direction) (nearest town)

Coarse sand w/ thin clay 18' 125'

Blue Clay 125' 180'

WELL PURPOSE: Home
(home, irrigation, municipal, industrial)

Med. sand 180' 205'

WELL COMPLETION DATA:

Blue Clay 205' 299'

- (1) diameter (inches) 2"
- (2) total depth (feet) 387'
- (3) static water level (feet) 20' below top of ground

Coarse white sand 299' 330'

Blue Clay w/ thin sand 330' 360'

- (4) casing PVC 347' (material) (depth)

Coarse ripper sand 360' 387'

- (5) screen 40' 347' (length) (depth to top)

- (6) pump 1/2 HP 13 (type power) (yield gpm)

- (7) electric log No (yes or no)

- (8) has well bottom plugged Backwash Valve

(organization running log)

DRILLERS REMARKS:


RECEIVED

JUL 10 1985

Department of Natural Resources
Bureau of Land & Water Resources

If well telescopes please sketch and show depths.

GROUND LEVEL

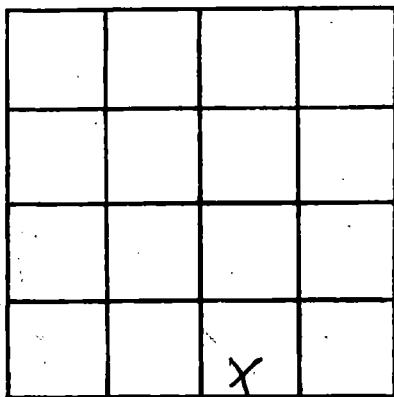

SECTION 19

Please indicate well location X.

ADDITIONAL INFORMATION

If more than one screen,
show locations of each on sketch.