

MISSISSIPPI DEPARTMENT OF NATURAL RESOURCES

Bureau of Land and Water Resources

Southport Mall

P.O. Box 10631

Jackson, Mississippi 39209

WATER WELL DRILLERS LOG

Jackson
2439
Aug 5, 1985 19 Coast water well Jackson
date well completed firm name county well located

LANDOWNER: Dave Winton
6017 Bel Fountain Rd
Ocean Springs, Miss
(mailing address) 39564

WELL LOCATION:
sec 17 T 8 N R 7 E
7 miles SE of OCEAN SPRINGS
(distance) (direction) (nearest town)

WELL PURPOSE: home
(home, irrigation, municipal, industrial)

WELL COMPLETION DATA:

- (1) diameter (inches) 2"
- (2) total depth (feet) 425'
- (3) static water level (feet) 21 below top of ground.
- (4) casing PVC, 415'
(material) (depth)
2" If telescope see back.
(size)
- (5) screen 10', 415'
(length) (depth to top)
2" PVC
(size) (material)
- (6) pump 1 hp., ---
(HP) (yield gpm)
Elect.
(type power)
- (7) electric log no
(yes or no)
- (organization running log)
- (8) how well bottom plugged Backwash valve

Description of formations encountered	from	to
Top Soil	0'	1'
White coarse sand	1'	10'
Blue Clay	10'	20'
Blue Clay & streak of sand	20'	155'
Blue Clay	155'	390'
Gray coarse sand	390'	420'
Gray coarse sand & gravel	420'	425'


RECEIVED

NOV - 1 1985

DRILLERS REMARKS: _____

If well telescopes please sketch and show depths.

GROUND LEVEL

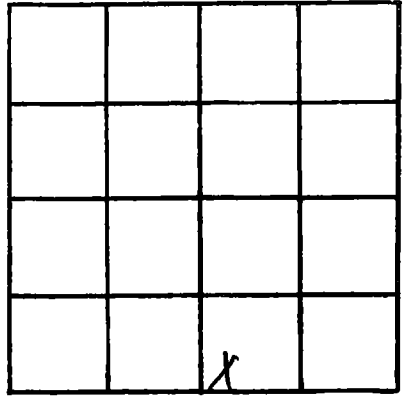

SECTION 17

Please indicate well location X.

ADDITIONAL INFORMATION

If more than one screen, show locations of each on sketch.