

MISSISSIPPI DEPARTMENT OF NATURAL RESOURCES

Bureau of Land and Water Resources

Southport Mall

P.O. Box 10631

Jackson, Mississippi 39209

WATER WELL DRILLERS LOG

JACKSON
 2440

11-5-85 19 Coast Water Well Sew. Jackson
 date well completed firm name county/well located

LANDOWNER	description of formations encountered	from	to
<u>Luth Comperell</u>	<u>White Coars Sand</u>	<u>0</u>	<u>20'</u>
<u>4521 Broussard St.</u>	<u>Blue Clay</u>	<u>20'</u>	<u>60'</u>
<u>Baton Rouge, La.</u>	<u>White Coars sand</u>	<u>60'</u>	<u>75'</u>
(mailing address)	<u>Blue Clay</u>	<u>75'</u>	<u>105'</u>
WELL LOCATION:	<u>Gravel</u>	<u>105'</u>	<u>135'</u>
sec. <u>18</u> T. <u>8</u> N. R. <u>7</u> W. <u>Spring</u>	<u>Blue Clay</u>	<u>135'</u>	<u>490'</u>
<u>5</u> miles <u>SE</u> of <u>Ocean</u>	<u>Blue Coars sand</u>	<u>490'</u>	<u>505'</u>
(distance) (direction) (nearest town)	<u>Blue Clay</u>	<u>505'</u>	<u>510'</u>
WELL PURPOSE: <u>Home</u>			
(home, irrigation, municipal, industrial)			
WELL COMPLETION DATA:			
(1) diameter (inches) <u>2"</u>			
(2) total depth (feet) <u>510'</u>			
(3) static water level (feet) <u>48'</u> below top of ground.			
(4) casing <u>PVC</u> , <u>495'</u>			
(material) (depth)			
<u>2"</u> If telescope see back.			
(size)			
(5) screen <u>10'</u> , <u>495'</u>			
(length) (depth to top)			
<u>2"</u> <u>PVC</u>			
(size) (material)			
(6) pump <u>1 1/2 HP</u> , <u>10</u>			
(HP) (yield gpm)			
<u>Elect.</u>			
(type power)			
(7) electric log <u>No</u>			
(yes or no)			
(organization running log)			
(8) how well bottom plugged.			
<u>Back Wash Valve</u>			

RECEIVED


JAN 08 1986

Department of Natural Resources
 Bureau of Land & Water Resources

DRILLERS REMARKS:
2" PVC Tail Pipe

If well telescopes please sketch and show depths.

GROUND LEVEL

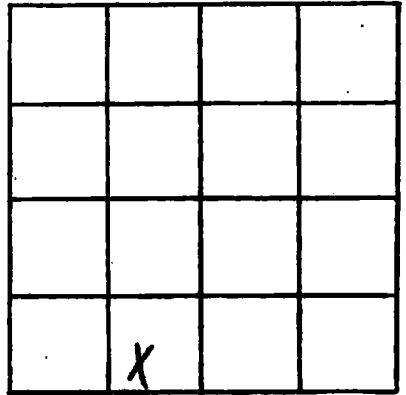

SECTION 18

Please indicate well location X.

ADDITIONAL INFORMATION

If more than one screen,
show locations of each on sketch.