

MISSISSIPPI DEPARTMENT OF NATURAL RESOURCES

Bureau of Land and Water Resources

Southport Mall

P.O. Box 10631


Jackson, Mississippi 39209

WATER WELL DRILLERS LOG

Jackson
 Φ
 2442

Jan 3, 1986 date well completed Coast Water Well firm name Jackson County well located


LANDOWNER: <u>Or Weaver</u>	description of formations encountered		from	to
<u>6530 Short Cut Rd</u>	Top Soil		0	3
<u>Mass Point, ms</u> (mailing address) <u>39563</u>	Blue Clay		3	59
WELL LOCATION: sec. <u>14</u> T. <u>8</u> S. R. <u>7</u> W. <u>1</u> miles <u>SOUTH</u> of <u>GAULTIER</u> (distance) (direction) (nearest town)	White Coarse Sand		59	107
WELL PURPOSE: <u>irrigation</u> (home, irrigation, municipal, industrial)	Blue Clay		107	140
WELL COMPLETION DATA: (1) diameter (inches) <u>2"</u>	White Coarse Sand		140	195
(2) total depth (feet) <u>300 ft</u>	Blue Clay		195	198
(3) static water level (feet) <u>32</u> below top of ground.	Mod. Gray Sand		198	225
(4) casing <u>PVC</u> , <u>285 ft</u> (material) (depth)	Gray Coarse Sand up clay		225	257
<u>2"</u> if telescope see back. (size)	Mod. Gray Sand		257	300
(5) screen <u>10 ft</u> , <u>285</u> (length) (depth to top)				
<u>2"</u> (size), <u>PVC</u> (material)				
(6) pump <u>1/2 HP</u> , <u>11</u> (HP) (yield gpm)				
<u>Elect.</u> (type power)				
(7) electric log <u>no</u> (yes or no)				
(organization running log)				
(8) has well bottom plugged <u>Backwash valve</u>				
DRILLERS REMARKS: <u>5ft 2" tail pipe</u>				

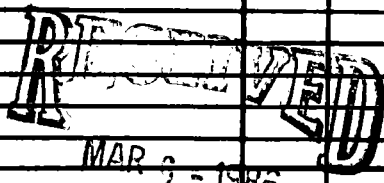

Department of Natural Resources
 Bureau of Land & Water Resources

If well telescopes please sketch and show depths.

GROUND LEVEL

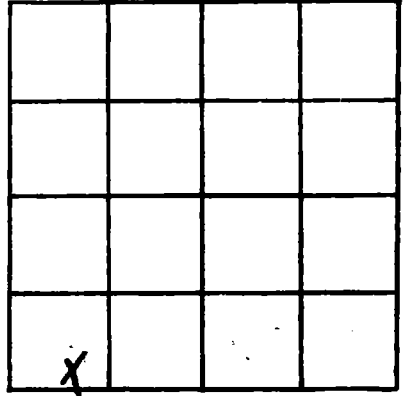

SECTION 14

Please indicate well location X.

ADDITIONAL INFORMATION

If more than one screen, show locations of each on sketch.