

MISSISSIPPI DEPARTMENT OF NATURAL RESOURCES

Bureau of Land and Water Resources

Southport Mall

P.O. Box 10631


Jackson, Mississippi 39209

WATER WELL DRILLERS LOG

Jackson
 Φ
 2443

Jan 11, 1986, Coastal water well Jackson
 date well completed firm name county well located

LANDOWNER:	description of formations encountered	from	to
Ophelia Hendley	Top Soil	0	7
3024 Ridgell Rd	White Coarse Sand	7	12
Mauree, MO 39553	Blue Clay + Oyster Shell	12	60
(mailing address)	White coarse sand + gravel	60	110
WELL LOCATION:	Blue Clay	110	147
sec. 18 T. 8 N. R. 7 E.	Gray fine sand	147	220
5 miles S/E of OCEAN SPRINGS	Blue Clay	220	316
(distance) (direction) of (nearest town)	Blue Clay + streak of sand	316	325
WELL PURPOSE: home	Blue Clay	325	350
(home, irrigation, municipal, industrial)	Blue Clay + Oyster Shell	350	460
WELL COMPLETION DATA:	Blue Clay	460	510
(1) diameter (inches) 2"	Gray coarse sand + gravel	510	522
(2) total depth (feet) 612'	Blue Clay	522	580
(3) static water level (feet) 26 below top of ground	Gray coarse sand	580	606
(4) casing PVC 587' (material) (depth)	Blue Clay + Oyster Shell	606	612
2" (size) If telescope see back.			
(5) screen 20' 587' (length) (depth to top)			
2" (size) PVC (material)			
(6) pump 1 (HP) 10 1/2 (yield gpm)			
Elect. (type power)			
(7) electric log no (yes or no)			
(organization running log)			
(8) has well bottom plugged			
backwash valve			

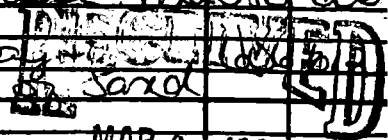

MAR 6 1986

DRILLERS REMARKS:
 5ft 2" tail pipe

If well telescopes please
sketch and show depths.

GROUND LEVEL

X			

SECTION 18

Please indicate well location X.

ADDITIONAL INFORMATION

If more than one screen,
show locations of each on sketch.