

MISSISSIPPI DEPARTMENT OF NATURAL RESOURCES

Bureau of Land and Water Resources

Southport Mall

P.O. Box 10631

Jackson, Mississippi 39209

WATER WELL DRILLERS LOG

Jackson  
 2444

Feb 3, 1986 Coastwater well Jackson  
 date well completed firm name county well located


| LANDOWNER:  | description of formations encountered | from | to  |
|---|---------------------------------------|------|-----|
| William Brantley<br>1716 Ladnier Rd<br>Ocean Springs, MS<br>(mailing address) 39564   |                                       |      |     |
| WELL LOCATION:<br>sec. 14 T. 8 S. R. 7 W.<br>1 miles SOUTH of GAULTIER<br>(distance) (direction) (nearest town)   | White Coarse sand                     | 1    | 25  |
| WELL PURPOSE: <u>home</u><br>(home, irrigation, municipal, industrial)  | Blue Clay                             | 25   | 62  |
| WELL COMPLETION DATA:<br>(1) diameter (inches) <u>2"</u><br>(2) total depth (feet) <u>100 ft</u><br>(3) static water level (feet) <u>15</u> below above top of ground.<br>(4) casing <u>PRC</u> , <u>85</u><br>(material) (depth)<br><u>2"</u> if telescope see back.<br>(size)<br>(5) screen <u>10'</u> , <u>85</u><br>(length) (depth to top)<br><u>2"</u> , <u>PRC</u><br>(size) (material)<br>(6) pump <u>1/2</u> , <u>7</u><br>(HP) (yield gpm)<br><u>Electric</u><br>(type power)<br>(7) electric log <u>no</u><br>(yes or no)<br>(organization running log)<br>(8) how well bottom plugged<br><u>Backwash pipe</u> | White Coarse sand                     | 62   | 100 |
| DRILLERS REMARKS:<br><u>5 ft 2" tail pipe</u>   |                                       |      |     |

RECEIVED  
 MAR 7 - 1986

Department of Natural Resources  
 Bureau of Land & Water Resources

If well telescopes please sketch and show depths.

GROUND LEVEL

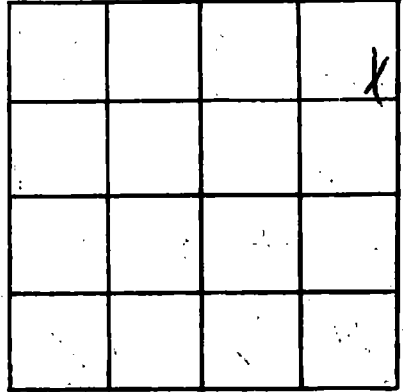

SECTION 14

Please indicate well location X.

ADDITIONAL INFORMATION

If more than one screen, show locations of each on sketch.