

MISSISSIPPI DEPARTMENT OF NATURAL RESOURCES

Bureau of Land and Water Resources

Southport Mall

P.O. Box 10631

Jackson, Mississippi 39209

WATER WELL DRILLERS LOG

JACKSON
 Φ
 2445

5-16-86

Coast Water Well

Jackson

date well completed

firm name

county well located

LANDOWNER: William Vick

7900 Belle Fountain

Ocean Springs Ms

(mailing address)

WELL LOCATION:

sec. 18 T. 8 N. R. 7 E.
5 miles SE of Ocean Springs
 (distance) (direction) (nearest town)

WELL PURPOSE: home
 (home, irrigation, municipal, industrial)

WELL COMPLETION DATA:

- (1) diameter (inches) 2"
- (2) total depth (feet) 380'
- (3) static water level (feet) 30' below
 top of ground. above
- (4) casing PVC, 355'
 (material) (depth)
2"
 (size) if telescope see back.
- (5) screen 20', 355"
 (length) (depth to top)
2" PVC
 (size) (material)
- (6) pump 1hp 12
 (HP) (yield gpm)
elect.
 (type power)
- (7) electric log no
 (yes or no)
 (organization running log)

(8) how well bottom plugged: backwash valve

DRILLERS REMARKS:

21-2" PVC tail pipe

description of formations encountered	from to	
White Coarse Sand	0	45
Blue Clay	45	60
White Coarse Sand	60	75
Blue Clay	75	195
Med Gray Sand	195	200
Blue Clay	200	237
Med Gray Sand	237	241
Blue Clay	241	300
Med Gray Sand	300	309
Blue Clay	309	343
Gray Med Sand	343	375


RECEIVED

AUG 20 1986

Department of Natural Resources
 Bureau of Land & Water Resources

If well telescopes please sketch and show depths.

GROUND LEVEL

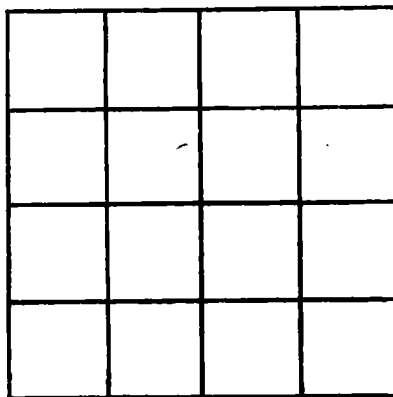

SECTION _____

Please indicate well location X.

ADDITIONAL INFORMATION

If more than one screen, show locations of each on sketch.