

JACKSON
 Ⓞ
 2447

MISSISSIPPI
 BOARD OF WATER COMMISSIONERS
 416 North State Street
 Jackson, Mississippi 39201

WATER WELL DRILLERS LOG

7-29 1986 St. Pierce Drilling Co. Jackson
 date well completed firm name county well located


LANDOWNER: Charley Goff
Douglas Blue
of Baloghi, ms
 (mailing address)

description of formations encountered	from	to
<u>2" sand</u>	<u>0</u>	<u>10</u>
<u>sand & clay</u>	<u>10</u>	<u>50</u>
<u>clay</u>	<u>50</u>	<u>100</u>
<u>sand</u>	<u>100</u>	<u>120</u>
<u>clay</u>	<u>120</u>	<u>370</u>
<u>sand</u>	<u>370</u>	<u>400</u>

WELL LOCATION:
 sec. 19 T. 8 N. R. 7 E
1 miles south of Coastline
 (distance) (direction) (nearest town)

WELL PURPOSE:
 (home irrigation, municipal, industrial)

- WELL COMPLETION DATA:
- (1) diameter (inches) 2"
 - (2) total depth (feet) 400'
 - (3) static water level (feet) 50 below above top of ground.
 - (4) casing plastic, 390'
 (material) (depth)
 - 0 if telescope see back.
 (size)
 - (5) screen 10', 400
 (length) (depth to top)
 - 006, plastic
 (size) (material)
 - (6) pump 1 10
 (HP) (yield gpm)
 - electric
 (type power)
 - (7) electric log (yes or no) no
 - (organization running log)
 - (8) how well bottom plugged BW

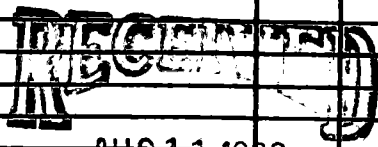


AUG 11 1986

DRILLERS REMARKS:

Department of Natural Resources
 Bureau of Land & Water Resources

If well telescopes please sketch and show depths.

GROUND LEVEL

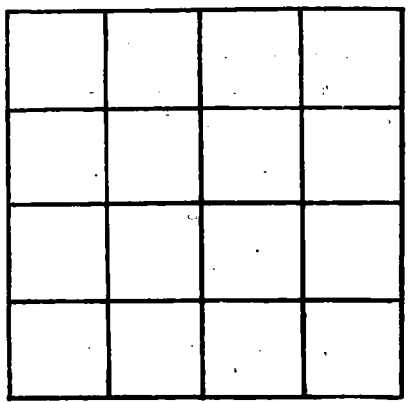

SECTION _____

Please indicate well location X.

ADDITIONAL INFORMATION

Lined area for additional information.

If more than one screen, show locations of each on sketch.