

MISSISSIPPI DEPARTMENT OF NATURAL RESOURCES
Bureau of Land and Water Resources
 Southport Mall
 P.O. Box 10631
 Jackson, Mississippi 39209
WATER WELL DRILLERS LOG

JACKSON
 0
 2449

8-6-86 19 Coast Water Well Jackson
 date well completed firm name county well located

LANDOWNER: John Hender
 1823 Hwy 90
 Gautier MS
 (mailing address)

WELL LOCATION:
 sec 18 T 8 N R 7 E
 7 miles SE of Ocean Springs
 (distance) (direction) (nearest town)

WELL PURPOSE: Home
 (home, irrigation, municipal, industrial)

WELL COMPLETION DATA:

(1) diameter (inches) 2"
 (2) total depth (feet) 535'
 (3) static water level (feet) 37 below top of ground.
 (4) casing PUC, 510' (material) (depth)
 2" (size) If telescope see back.
 (5) screen 20' 510' (length) (depth to top)
 2" (size) PUC (material)
 (6) pump 1hp 10 (HP) (yield gpm)
 elect. (type power)
 (7) electric log no (yes or no)
 (organization running log)
 (8) how well bottom plugged Backwash valve

description of formations encountered	from	to
Top Soil	0	10
Blue Clay + Clam Shell	10	86
White Coarse Sand	86	110
Blue Clay	110	235
Blue Clay + Streak of Sand	235	260
Blue Clay + Oyster Shell	260	400
Gray Fine Sand	400	450
Gray Coarse Sand	450	470
Blue Clay	470	507
Gray Med Sand	507	530
Blue Clay	530	535


RECEIVED
 SEP 11 1986

Department of Natural Resources
 Bureau of Land & Water Resources

DRILLERS REMARKS:
 5'-2" PUC tailpipe

If well telescopes please sketch and show depths.

GROUND LEVEL

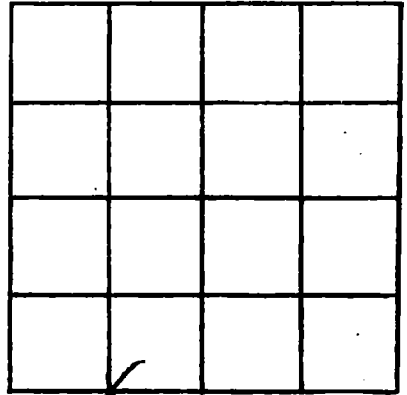

SECTION 18

Please indicate well location X.

ADDITIONAL INFORMATION

If more than one screen, show locations of each on sketch.