

100-
MISSISSIPPI DEPARTMENT OF NATURAL RESOURCES
 Bureau of Land and Water Resources

P.O. Box 10631
 Jackson, Mississippi 39209
WATER WELL DRILLERS LOG

COUNTY WELL LOCATED <i>Jackson</i>		PERMIT NUMBER
WELL NUMBER Φ 2451	CODED	
DATE WELL COMPLETED 7-10-87		NAME OF DRILLING FIRM <i>Coast Water Well Service</i>

NAME & MAILING ADDRESS OF LANDOWNER <i>Bobbie Canterbury</i>			
538 Peach St.			
Ocean Springs			
WELL LOCATION: SEC	TOWNSHIP	RANGE	
19	8	N 7	W
DISTANCE 4 Miles	DIRECTION SW	NEAREST TOWN GAUTIER	
OTHER LANDMARK			
WELL PURPOSE: Home, Irrigation, Municipal, Industrial, Fish Pond, etc. <i>home</i>			

PUMP DATA		
PUMP TYPE (Circle One): Submersible, Turbine, Jet Flowing Well, Other (Describe)		
POWER TYPE (Circle One): Electric , Tractor, Diesel, Gasoline, Butane, Other (Describe)		
Pump Capacity (GPM) 10	No. of Stages 2	Setting Depth — FT.
PUMP TEST		
Well yielded _____ GPM with a drawdown of _____ ft. after _____ hours of pumping		

WELL DATA		
Well Depth 400'	Casing Diameter (In.) 2"	Casing Length (Ft.) 385'
Type of Casing PVC	Hole Depth 400'	Depth to Static Water Level 35'
TYPE OF COMPLETION: (Circle One or More): Natural Development , Underreamed, Telescoped, Open Hole, Other		
Top of Lap Pipe or Reduction in Casing		
FEET	IF TELESKOPED OR MORE THAN ONE SCREEN: USE BACK PAGE	

LOG DATA	
TYPE OF LOG RUN (Circle One): Electric, Gamma Ray, Density, Sonic, No Log Run , Neutron, Other (Describe)	
Name of Organization Running Log	

SCREEN DATA		
Diameter - Inches 2"	Length - Feet 15'	Slot Size - Inches .008
Screen Type PVC	Depth to Bottom - Feet 400'	


GEOLOGIC DATA (Office Use Only)			
Surface Elev.	Geologic Unit	Unit Thickness	Depth to Top
Subs. SWL	Date	Analysis	Aquifer Test
Driller's Remarks			

DESCRIPTION OF FORMATIONS ENCOUNTERED	FROM	TO
<i>White coarse Sand</i>	<i>0</i>	<i>120</i>
<i>Blue Clay</i>	<i>120</i>	<i>122</i>
<i>Gray Med. Sand</i>	<i>122</i>	<i>150</i>
<i>Blue Clay</i>	<i>150</i>	<i>260</i>
<i>Fine Gray Sand</i>	<i>260</i>	<i>270</i>
<i>Blue Clay</i>	<i>270</i>	<i>370</i>
<i>Fine Gray Sand</i>	<i>370</i>	<i>380</i>
<i>Gray Med. Sand</i>	<i>380</i>	<i>395</i>
<i>Blue Clay</i>	<i>395</i>	<i>400</i>

<div style="font-size: 2em; font-weight: bold; border: 2px solid black; padding: 5px; display: inline-block;">RECEIVED</div>
<div style="font-size: 1.5em; font-weight: bold;">SEP 21 1987</div>
Department of Natural Resources Bureau of Land & Water Resources
IF MORE SPACE IS NEEDED, USE BACK

If well telescopes please sketch and show depths.

GROUND LEVEL

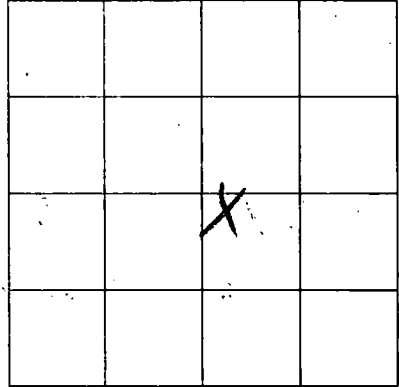

SECTION 19

Please indicate well location X.

ADDITIONAL INFORMATION

Multiple horizontal lines for additional information.

If more than one screen, show location of each on sketch.