

MISSISSIPPI DEPARTMENT OF NATURAL RESOURCES
Bureau of Land and Water Resources

P.O. Box 10631
Jackson, Mississippi 39209
WATER WELL DRILLERS LOG

COUNTY WELL LOCATED <i>Jac Bson</i>		PERMIT NUMBER
WELL NUMBER 2453	CODED	NAME OF DRILLING FIRM <i>Coast Water Well Service</i>
DATE WELL COMPLETED 9-7-88		

NAME & MAILING ADDRESS OF LANDOWNER <i>Michael Trahan</i>		
<i>East Belle Fountain</i>		
<i>Ocean Springs MS</i>		
WELL LOCATION: SEC	TOWNSHIP	RANGE
19	8	7
	S	W
DISTANCE 3 Miles	DIRECTION SW	NEAREST TOWN Cautledge
OTHER LANDMARK		
WELL PURPOSE: Home, Irrigation, Municipal, Industrial, Fish Pond, etc. home		

PUMP DATA		
PUMP TYPE (Circle One): Submersible, Turbine, Jet Flowing Well, Other (Describe) _____		
POWER TYPE (Circle One): Electric , Tractor, Diesel, Gasoline, Butane, Other (Describe) _____		
Pump Capacity (GPM) 11	No. of Stages 2	Setting Depth - FT.
PUMP TEST		
Well yielded _____ GPM with a drawdown of _____ ft. after _____ hours of pumping		

WELL DATA		
Well Depth 392	Casing Diameter (In.) 2"	Casing Length (Ft.) 377
Type of Casing PVC	Hole Depth 392	Depth to Static Water Level 31'
TYPE OF COMPLETION: (Circle One or More): Natural Development , Gravel Packed, Underreamed, Telescoped, Open Hole, Other (Describe) _____		
Top of Lap Pipe or Reduction in Casing		
FEET	IF TELESCOPED OR MORE THAN ONE SCREEN: USE BACK PAGE	

LOG DATA	
TYPE OF LOG RUN (Circle One): Electric, Gamma Ray, Density, Sonic, No Log Run , Neutron, Other (Describe) _____	
Name of Organization Running Log	

SCREEN DATA		
Diameter - Inches 2"	Length - Feet 10'	Slot Size - Inches .008
Screen Type PVC	Depth to Bottom - Feet 387	


GEOLOGIC DATA (For Use Only)			
Surface Elev.	Geologic Unit	Unit Thickness	Depth to Top
Subs. SWL	Date	Analysis	Analysis Test
Driller's Remarks NOV 15 1988			
Department of Natural Resources Bureau of Land & Water Resources			

DESCRIPTION OF FORMATIONS ENCOUNTERED	FROM	TO	FORMATIONS (Continued)	FROM	TO
<i>Top Soil</i>	<i>0</i>	<i>3</i>	<i>Blue Clay</i>	<i>338</i>	<i>363</i>
<i>White Coarse Sand</i>	<i>3</i>	<i>8</i>	<i>Blue Clay with Shale</i>	<i>363</i>	<i>373</i>
<i>Brown Coarse Sand</i>	<i>8</i>	<i>105</i>	<i>Gray Med. Sand</i>	<i>373</i>	<i>387</i>
<i>Blue Clay</i>	<i>105</i>	<i>192</i>	<i>Blue Clay</i>	<i>387</i>	<i>392</i>
<i>Gray Fine Sand</i>	<i>192</i>	<i>213</i>			
<i>Blue Clay with Shale</i>	<i>213</i>	<i>236</i>			
<i>Blue Clay</i>	<i>236</i>	<i>262</i>			
<i>Gray Fine Sand</i>	<i>262</i>	<i>270</i>			
<i>Blue Clay</i>	<i>270</i>	<i>321</i>			
<i>Gray Med. Sand</i>	<i>-</i>	<i>-</i>			
<i>1/2" Shale of Clay</i>	<i>321</i>	<i>338</i>			

IF MORE SPACE IS NEEDED, USE BACK

If well telescopes please sketch and show depths.

GROUND LEVEL

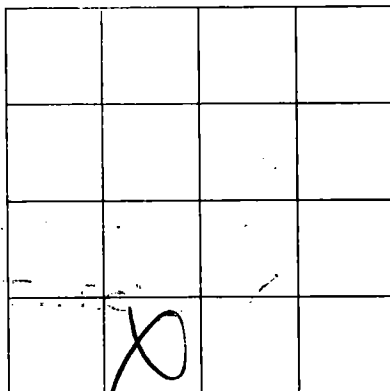

SECTION 19

Please indicate well location X.

ADDITIONAL INFORMATION

If more than one screen,
show location of each on sketch.