

MISSISSIPPI DEPARTMENT OF ENVIRONMENTAL QUALITY

Office of Land and Water Resources

P. O. Box 10631

Jackson, MS 39289-0631

WATER WELL DRILLERS LOG

COUNTY WELL LOCATED
Jackson

WELL NUMBER CODED
2500

DATE WELL COMPLETED
7-3-98

PERMIT NUMBER

NAME OF DRILLING FIRM
Coast Water Well Service

NAME & MAILING ADDRESS OF LANDOWNER
Chuck Burkes
Tangwood
Ocean Springs, Ms

WELL LOCATION: SEC TOWNSHIP RANGE
19 8th 7th W

DISTANCE DIRECTION NEAREST TOWN
5 Miles **SE** of **Ocean Springs**

OTHER LANDMARK

WELL PURPOSE: Home, Irrigation, Municipal, Industrial, Fish Pond, etc.

PUMP DATA

PUMP TYPE (Circle One):
 Submersible Turbine, Jet Flowing Well.
Other (Describe) _____

POWER TYPE (Circle One):
 Electric, Tractor, Diesel, Gasoline, Butane.
Other (Describe) _____ H/P **1**

Pump Capacity (GPM)	No. of Stages	Setting Depth
10	10	120 FT.

PUMP TEST

Well yielded _____ GPM with a drawdown of _____ ft. after _____ hours of pumping

WELL DATA

Well Depth 400'	Casing Diameter (In.) 4x2"	Casing Length (Ft.) 200-4" 180-2"
Type of Casing PVC	Hole Depth 405'	Depth to Static Water Level 47'

LOG DATA

TYPE OF LOG RUN (Circle One):
 No Log Run, Electric, Gamma Ray, Density, Sonic, Neutron, Other (Describe) _____

Name of Organization Running Log

TYPE OF COMPLETION: (Circle One or More):
 Gravel Packed, Underreamed, Telescoped, Natural Development, Open Hole, Other

WELL GROUTED TO A DEPTH OF **20** FEET
Type Grout (circle one): Cement, Bentonite, or Mix

GEOLOGIC DATA (Office Use Only)

Surface Elev.	Geologic Unit	Unit Thickness	Depth to Top
Subs. SWL	Date	Analysis	Aquifer Test

SCREEN DATA

Diameter - Inches 2"	Length - Feet 20'	Slot Size - Inches .008
Screen Type PVC	Depth to Bottom - Feet 405'	

Driller's Remarks

08-26-98 A09:43 RCVD

Top of Lap Pipe or Reduction in Casing


FEET IF TELESCOPED OR MORE THAN ONE SCREEN: USE BACK PAGE

DESCRIPTION OF FORMATIONS ENCOUNTERED	FROM	TO	FORMATIONS (Continued)	FROM	TO
Coarse Sand	0	75			
Black Mud	75	85			
Log	35				
Log	60				
Coarse Sand	185	127			
Blue clay sand	127	205			
Med Sand	205	212			
Blue clay sand	212	350			
Coarse Sand	350	405			

IF MORE SPACE IS NEEDED, USE BACK

If well telescopes please
sketch and show depths.

GROUND LEVEL

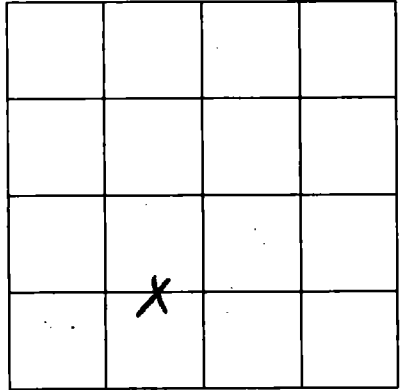

SECTION 19

Please indicate well location X.

ADDITIONAL INFORMATION

If more than one screen,
show location of each on sketch.