

COUNTY WELL LOCATED
Jackson
 WELL NUMBER CODED
 2530
 DATE WELL COMPLETED
 1-16-99

PERMIT NUMBER
 NAME OF DRILLING FIRM
Coast Water Well Service

NAME & MAILING ADDRESS OF LANDOWNER
Tom Hansen
Soundbluff Dr.
Ocean Springs Ms.
 WELL LOCATION: SEC TOWNSHIP RANGE
 19 8 S 7 W
 DISTANCE DIRECTION NEAREST TOWN
 6 1/2 Miles SE of Ocean Springs
 OTHER LANDMARK
 WELL PURPOSE: Home Irrigation, Municipal, Industrial, Fish Pond, etc.

PUMP DATA
 PUMP TYPE (Circle One): Submersible Turbine Jet Flowing Well
 Other (Describe)
 POWER TYPE (Circle One): Electric Tractor Diesel Gasoline Butane
 Other (Describe) H/P 1 1/2
 Pump Capacity (GPM) No. of Stages Setting Depth
 20-25 10 100' FT.
 PUMP TEST
 Well yielded _____ GPM with
 a drawdown of _____ ft.
 after _____ hours of pumping

WELL DATA
 Well Depth Casing Diameter (In.) Casing Length (Ft.)
 395' 4"x2" 200'-4"
 175'-2"
 Type of Casing Hole Depth Depth to Static Water Level
 PVC 397' 50'

LOG DATA
 TYPE OF LOG RUN (Circle One): No Log Run
 Electric, Gamma Ray, Density, Sonic, Neutron,
 Other (Describe)
 Name of Organization Running Log

TYPE OF COMPLETION: (Circle One or More):
Gravel Packed, Underreamed, Telescoped,
Natural Development, Open Hole, Other
 (Describe)
 WELL GROUTED TO A DEPTH OF 20 FEET
 Type Grout (circle one): Cement, Bentonite, or Mix

GEOLOGIC DATA (Office Use Only)

Surface Elev.	Geologic Unit	Unit Thickness	Depth to Top
Subs. SWL	Date	Analysis	Aquifer Test

SCREEN DATA
 Diameter - Inches Length - Feet Slot Size - Inches
 2" 20' .008
 Screen Type Depth to Bottom - Feet
 PVC 395'

Driller's Remarks

DESCRIPTION OF FORMATIONS ENCOUNTERED	FROM	TO
Coarse Sand	0	110
Coarse Sand & Log	95'	
Blue Clay	110	170
Med Sand	170	180
Blue Clay	180	190
Fine Med Sand	190	231
Blue Clay	231	360
Med Sand	360	397


RECEIVED

APR 05 1999

Dept of Environmental Quality
 Office of Land & Water Resources

Please
and show depths.

GROUND LEVEL

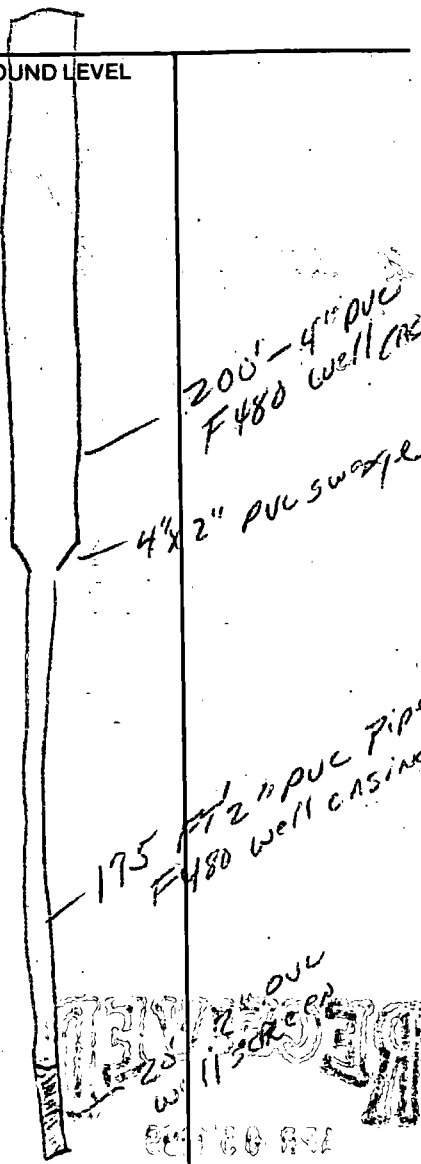

	X		

SECTION 19

Please indicate well location X.

ADDITIONAL INFORMATION

A series of horizontal lines provided for entering additional information, currently blank.

If more than one screen, show location of each on sketch.