

**MISSISSIPPI DEPARTMENT OF ENVIRONMENTAL QUALITY**  
Office of Land and Water Resources

P. O. Box 10631  
Jackson, MS 39289-0631  
**WATER WELL DRILLERS LOG**

COUNTY WELL LOCATED <i>Jackson</i>	
WELL NUMBER <i>2601</i>	CODED <i>2477</i>
DATE WELL COMPLETED <i>9-7-95</i>	

PERMIT NUMBER
NAME OF DRILLING FIRM <i>Coast Water Well Service</i>

NAME & MAILING ADDRESS OF LANDOWNER <i>Lee Stine</i>		
<i>Bellifountain Beach</i>		
<i>Ocean Springs, Ms</i>		
WELL LOCATION: SEC	TOWNSHIP	RANGE
<i>19</i>	<i>8</i>	<i>7</i>
DISTANCE	DIRECTION	NEAREST TOWN
<i>3 1/2</i> Miles	<i>SW</i>	of <i>Canton</i>
OTHER LANDMARK		
WELL PURPOSE <input checked="" type="radio"/> Home, <input type="radio"/> Irrigation, <input type="radio"/> Municipal, <input type="radio"/> Industrial, <input type="radio"/> Fish Pond, etc.		

<b>PUMP DATA</b>		
PUMP TYPE (Circle One): Submersible, Turbine, <input checked="" type="radio"/> Jet, Flowing Well, Other (Describe) _____		
POWER TYPE (Circle One): <input checked="" type="radio"/> Electric, Tractor, Diesel, Gasoline, Butane, Other (Describe) _____ H/P <i>1</i>		
Pump Capacity (GPM) <i>9</i>	No. of Stages <i>2</i>	Setting Depth  FT.
PUMP TEST		
Well yielded _____ GPM with a drawdown of _____ ft. after _____ hours of pumping		

<b>WELL DATA</b>		
Well Depth <i>380'</i>	Casing Diameter (In.) <i>2"</i>	Casing Length (Ft.) <i>370'</i>
Type of Casing <i>PVC</i>	Hole Depth <i>380'</i>	Depth to Static Water Level <i>40'</i>

<b>LOG DATA</b>	
TYPE OF LOG RUN (Circle One): Electric, Gamma Ray, Density, Sonic, Neutron, Other (Describe) _____	
<input checked="" type="radio"/> No Log Run	
Name of Organization Running Log	

TYPE OF COMPLETION: (Circle One or More): <input checked="" type="checkbox"/> Gravel Packed, <input type="checkbox"/> Underreamed, <input type="checkbox"/> Telescoped, <input checked="" type="checkbox"/> Natural Development, <input type="checkbox"/> Open Hole, <input type="checkbox"/> Other		
WELL GROUTED TO A DEPTH OF <i>30</i> FEET Type Grout (circle one): <input checked="" type="radio"/> Cement, <input type="radio"/> Bentonite, or <input type="radio"/> Mix		

<b>GEOLOGIC DATA (Office Use Only)</b>			
Surface Elev.	Geologic Unit	Unit Thickness	Depth to Top
Subs. SWL	Date	Analysis	Aquifer Test

<b>SCREEN DATA</b>		
Diameter - Inches <i>2"</i>	Length - Feet <i>10'</i>	Slot Size - Inches <i>.008</i>
Screen Type <i>PVC</i>	Depth to Bottom - Feet <i>380'</i>	

Driller's Remarks

DESCRIPTION OF FORMATIONS ENCOUNTERED	FROM	TO
<i>Coarse Sand &amp; Gravel</i>	<i>0</i>	<i>140</i>
<i>Blue Clay with pebbles</i>	<i>140</i>	<i>190</i>
<i>Med. Sand</i>	<i>190</i>	<i>240</i>
<i>Blue Clay</i>	<i>240</i>	<i>289</i>
<i>Fine Sand</i>	<i>289</i>	<i>295</i>
<i>Blue Clay</i>	<i>295</i>	<i>325</i>
<i>Med. Sand</i>	<i>325</i>	<i>335</i>
<i>Blue Clay</i>	<i>335</i>	<i>350</i>
<i>Med. Sand</i>	<i>350</i>	<i>380</i>

FORMATIONS (C)	FROM	TO

**RECEIVED**


OCT 13 1995

Dept. of Environmental Quality  
Office of Land & Water Resources

IF MORE SPACE IS NEEDED, USE BACK

If well telescopes please sketch and show depths.

GROUND LEVEL

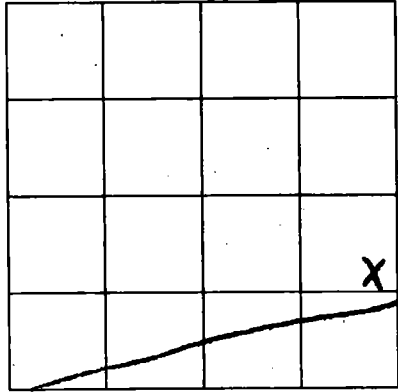

SECTION 19

Please indicate well location X.

ADDITIONAL INFORMATION

If more than one screen, show location of each on sketch.