

MISSISSIPPI DEPARTMENT OF ENVIRONMENTAL QUALITY
Office of Land and Water Resources

P. O. Box 10631
Jackson, MS 39289-0631
WATER WELL DRILLERS LOG

COUNTY WELL LOCATED Jackson	
WELL NUMBER 2053	CODED
DATE WELL COMPLETED 10-16-95	

PERMIT NUMBER
NAME OF DRILLING FIRM Coast Water Well Service

NAME & MAILING ADDRESS OF LANDOWNER Jason Dahl Old Shell Landing Rd. Gautier, Ms		
WELL LOCATION: SEC	TOWNSHIP	RANGE
4	8	7
DISTANCE	DIRECTION	NEAREST TOWN
3 Miles	SW	of GAUTIER
OTHER LANDMARK		
WELL PURPOSE: <input checked="" type="checkbox"/> Home Irrigation, <input type="checkbox"/> Municipal, <input type="checkbox"/> Industrial, <input type="checkbox"/> Fish Pond, etc.		

PUMP DATA		
PUMP TYPE (Circle One): Submersible, Turbine, <input checked="" type="radio"/> Jet, Flowing Well, Other (Describe) _____		
POWER TYPE (Circle One): <input checked="" type="radio"/> Electric, Tractor, Diesel, Gasoline, Butane, Other (Describe) _____ H/P <input checked="" type="checkbox"/>		
Pump Capacity (GPM)	No. of Stages	Setting Depth
12	2	_____ FT.
PUMP TEST		
Well yielded _____ GPM with a drawdown of _____ ft. after _____ hours of pumping		

WELL DATA		
Well Depth 320'	Casing Diameter (In.) 2"	Casing Length (Ft.) 310'
Type of Casing PVC	Hole Depth 320'	Depth to Static Water Level 25'

LOG DATA	
TYPE OF LOG RUN (Circle One): Electric, Gamma Ray, Density, <input checked="" type="radio"/> No Log Run, Sonic, Neutron, Other (Describe) _____	
Name of Organization Running Log	

TYPE OF COMPLETION: (Circle One or More):
 Gravel Packed, Underreamed, Telescoped,
 Natural Development, Open Hole, Other
(Describe) _____

WELL GROUTED TO A DEPTH OF **20** FEET
Type Grout (circle one): Cement, Bentonite, or Mix

GEOLOGIC DATA (Office Use Only)			
Surface Elev.	Geologic Unit	Unit Thickness	Depth to Top
Subs. SWL	Date	Analysis	Aquifer Test

SCREEN DATA		
Diameter - Inches 2"	Length - Feet 10'	Slot Size - Inches .008
Screen Type PVC	Depth to Bottom - Feet 320'	


Driller's Remarks

DESCRIPTION OF FORMATIONS ENCOUNTERED	FROM	TO	FORMATIONS (Continued)	FROM	TO
Top Soil	0	2			
Grey orange Clay	2	10			
Med sand	10	18			
Blue Clay - shell	18	55			
Coarse sand	55	70			
Blue Clay streaky sand	70	220			
Medium sand streaky clay	220	320			

IF MORE SPACE IS NEEDED, USE BACK

If well telescopes please
sketch and show depths.

GROUND LEVEL

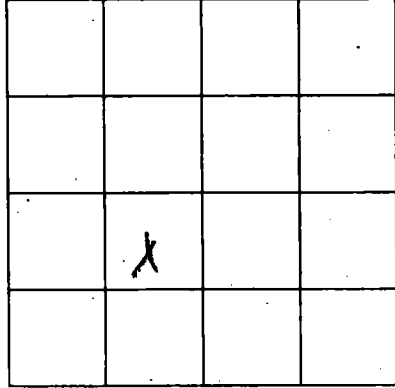

SECTION 4

Please indicate well location X.

ADDITIONAL INFORMATION

If more than one screen,
show location of each on sketch.