

MISSISSIPPI DEPARTMENT OF ENVIRONMENTAL QUALITY

Office of Land and Water Resources

P. O. Box 10631
Jackson, MS 39289-0631
WATER WELL DRILLERS LOG

COUNTY WELL LOCATED
Cochran

WELL NUMBER 8-965 CODED

DATE WELL COMPLETED
10-4-01

PERMIT NUMBER

NAME OF DRILLING FIRM
Coast Water Well Service

NAME & MAILING ADDRESS OF LANDOWNER
Richard Alexander
MARGARET ST.
Ocean Springs, Ms

Latitude:
Longitude:

WELL LOCATION SEC 8 TOWNSHIP 8th RANGE 7th

DISTANCE 6 Miles DIRECTION SE of NEAREST TOWN Ocean Springs

OTHER LANDMARK

WELL PURPOSE Home Irrigation, Municipal, Industrial, Fish Pond, etc.

PUMP DATA

PUMP TYPE (Circle One):
Submersible, Turbine, Jet Flowing Well,
Other (Describe)

POWER TYPE (Circle One):
 Electric Tractor, Diesel, Gasoline, Butane,
Other (Describe) H/P

DESCRIPTION OF FORMATIONS ENCOUNTERED	FROM	TO
Top Soil	0	2
Blue and Orange Clay	2	18
White Coarse Sand	18	54
Gray Clay	54	115
Gray Low Medium Sand	115	126
Blue Clay / Shell Sand	126	336
Medium and Coarse Sand	336	358

REC'D JAN 22 2002

Top of Lap Pipe or Reduction in Casing

FEET IF TELESCOPED OR MORE THAN ONE SCREEN: USE BACK PAGE

WELL DATA

Well Depth 358' Casing Diameter (In.) 2" Casing Length (FT.) 343'

Type of Casing PVC Hole Depth 358' Depth to Static Water Level 40'

TYPE OF COMPLETION: (Circle One or More):
 Gravel Packed Underreamed, Telescoped,
 Natural Development, Open Hole, Other
(Describe)

WELL GROUTED TO A DEPTH OF 10 FEET
Type Grout (circle one): Cement, Bentonite, or Mix

SCREEN DATA

Diameter - Inches 2" Length - Feet, 15 Slot Size - Inches .004

Screen Type PVC Depth to Bottom - Feet 358


I certify that the well was drilled, constructed and completed in accordance with all applicable Requirements of the Mississippi Department of Environmental Quality and/or the Mississippi Department of Health regulations and state laws.

Jack Ridgell 472
Signature of Licensed Driller and License No.

12-28-01
Date

If well telescopes please sketch and show depths.

GROUND LEVEL

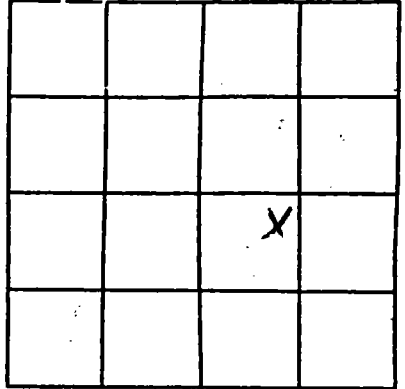

SECTION 8

Please indicate well location X.

Pump Capacity (GPM) <u>8.5</u>	No. of Stages <u>2</u>	Setting Depth _____ FT.
-----------------------------------	---------------------------	----------------------------

PUMP TEST

Well yielded _____ GPM with
a drawdown of _____ ft.
after _____ hours of pumping

LOG DATA

TYPE OF LOG RUN (Circle One): No Log Run
Electric, Gamma Ray, Density, Sonic, Neutron,
Other (Describe) _____

Name of Organization Running Log _____

GEOLOGIC DATA (Office Use Only)

Surface Elev.	Geologic Unit	Unit Thickness	Depth to Top
Subs. SWL	Date	Analysis	Aquifer Test

Driller's Remarks

If more than one screen,
show location of each on sketch.