

MISSISSIPPI DEPARTMENT OF ENVIRONMENTAL QUALITY

Office of Land and Water Resources

P. O. Box 10631
Jackson, MS 39289-0631
WATER WELL DRILLERS LOG

COUNTY WELL LOCATED
Clackson

WELL NUMBER CODED
0-21056

DATE WELL COMPLETED
1-8-02

PERMIT NUMBER

NAME OF DRILLING FIRM
Cost Water Well Service

NAME & MAILING ADDRESS OF LANDOWNER
Ronald McAllister
Brown Rd.
Ocean Springs, Ms 39564

Latitude:
Longitude:

WELL LOCATION SEC TOWNSHIP RANGE
29 7 N 7 E

DISTANCE DIRECTION NEAREST TOWN
IN Miles — of Gaucher

OTHER LANDMARK

WELL PURPOSE: Home, Irrigation, Municipal, Industrial, Fish Pond, etc.

PUMP DATA

PUMP TYPE (Circle One):
Submersible, Turbine, Flowing Well, Other (Describe) _____

POWER TYPE (Circle One):
 Electric, Tractor, Diesel, Gasoline, Butane, Other (Describe) _____ H/P 1

DESCRIPTION OF FORMATIONS ENCOUNTERED	FROM	TO
<u>Top Soil</u>	<u>0</u>	<u>2</u>
<u>Orange Clay</u>	<u>2</u>	<u>11</u>
<u>White Coarse Sand</u>	<u>11</u>	<u>31</u>
<u>White + Blue Clay</u>	<u>31</u>	<u>102</u>
<u>Medium + Coarse Sand</u>	<u>102</u>	<u>147</u>

RECEIVED
MAR 15 2002

Dept. of Environmental Quality
Office of Land & Water Resources

Top of Lap Pipe or Reduction in Casing
FEET IF TELESCOPED OR MORE THAN ONE SCREEN: USE BACK PAGE

WELL DATA

Well Depth 147' Casing Diameter (In.) 2" Casing Length (Ft.) 137'

Type of Casing PVC Hole Depth 147' Depth to Static Water Level 15'

TYPE OF COMPLETION: (Circle One or More):
 Gravel Packed, Underreamed, Telescoped, Natural Development, Open Hole, Other (Describe) _____

WELL GROUTED TO A DEPTH OF 10 FEET
Type Grout (circle one): Cement, Bentonite or Mix

SCREEN DATA

Diameter - Inches 2" Length - Feet 10' Slot Size - Inches .008

Screen Type PVC Depth to Bottom - Feet 147'

I certify that the well was drilled, constructed and completed in accordance with all applicable Requirements of the Mississippi Department of Environmental Quality and/or the Mississippi Department of Health regulations and state laws.


Jack Rydell 472
Signature of Licensed Driller and License No.

3/8/02
Date

Additional Information Required On Back

If well telescopes please sketch and show depths.

GROUND LEVEL

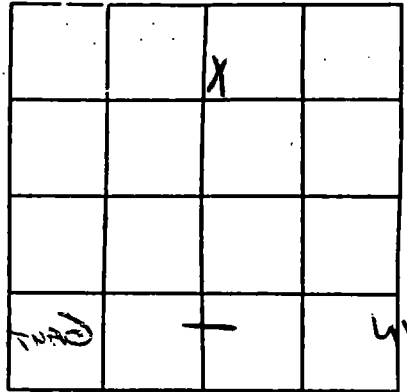

SECTION 29

Please indicate well location X.

Pump Capacity (GPM) <u>9</u>	No. of Stages <u>2</u>	Setting Depth _____ FT.
---------------------------------	---------------------------	----------------------------

PUMP TEST

Well yielded _____ GPM with
a drawdown of _____ ft.
after _____ hours of pumping

LOG DATA

TYPE OF LOG RUN (Circle One): No Log Run,
Electric, Gamma Ray, Density, Sonic, Neutron,
Other (Describe) _____

Name of Organization Running Log _____

GEOLOGIC DATA (Office Use Only)

Surface Elev.	Geologic Unit	Unit Thickness	Depth to Top
Subs. SWL	Date	Analysis	Aquifer Test

Driller's Remarks

If more than one screen,
show location of each on sketch.