

**MISSISSIPPI DEPARTMENT OF ENVIRONMENTAL
QUALITY**
Office of Land and Water Resources

P. O. Box 10631
Jackson, MS 39289-0631
WATER WELL DRILLERS LOG

COUNTY WELL LOCATED JACKSON	CODED
WELL NUMBER 0-27669	
DATE WELL COMPLETED 6-14-02	

PERMIT NUMBER
NAME OF DRILLING FIRM Coast Water Well Service

NAME & MAILING ADDRESS OF LANDOWNER Jim Gray Belle Fountain			
Latitude:			
Longitude:	Ocean Springs		
WELL LOCATION:	SEC	TOWNSHIP	RANGE
	18	8	7th
DISTANCE	DIRECTION	NEAREST TOWN	
5 Miles	SE	of Ocean Springs	
OTHER LANDMARK			
WELL PURPOSE: <input checked="" type="checkbox"/> Home Irrigation, <input type="checkbox"/> Municipal, <input type="checkbox"/> Industrial, <input type="checkbox"/> Fish Pond, etc.			

PUMP DATA	
PUMP TYPE (Circle One): <input checked="" type="checkbox"/> Submersible, <input type="checkbox"/> Turbine, <input type="checkbox"/> Jet, <input type="checkbox"/> Flowing Well, Other (Describe) _____	
POWER TYPE (Circle One): <input checked="" type="checkbox"/> Electric, <input type="checkbox"/> Tractor, <input type="checkbox"/> Diesel, <input type="checkbox"/> Gasoline, <input type="checkbox"/> Butane, Other (Describe) _____ H/P 1 1/2	

DESCRIPTION OF FORMATIONS ENCOUNTERED	FROM	TO
Top Soil	0	8
Blue Clay	8	101
White Coarse Sand	101	130
Blue clay w/str of sand	130	485
Medium Sand	485	501

RECEIVED

AUG 12 2002

BY: OLWR

Top of Lap Pipe or Reduction in Casing	FEET	IF TELESCOPED OR MORE THAN ONE SCREEN: USE BACK PAGE

WELL DATA		
Well Depth 501'	Casing Diameter (In.) 4x2	Casing Length (Ft.) 486'
Type of Casing PVC	Hole Depth 501'	Depth to Static Water Level 50'
TYPE OF COMPLETION: (Circle One or More): <input type="checkbox"/> Gravel Packed, <input type="checkbox"/> Underreamed, <input type="checkbox"/> Telescoped, <input checked="" type="checkbox"/> Natural Development, <input type="checkbox"/> Open Hole, <input type="checkbox"/> Other (Describe) _____		
WELL GROUTED TO A DEPTH OF 10 FEET Type Grout (circle one): Cement, <input checked="" type="checkbox"/> Bentonite, or Mix		


SCREEN DATA		
Diameter - Inches 2"	Length - Feet 15'	Slot Size - Inches .004
Screen Type PVC	Depth to Bottom - Feet 501'	

I certify that the well was drilled, constructed and completed in accordance with all applicable Requirements of the Mississippi Department of Environmental Quality and/or the Mississippi Department of Health regulations and state laws.

Jack Russell 472
Signature of Licensed Driller and License No.

7/24/02
Date

If well telescopes please sketch and show depths.

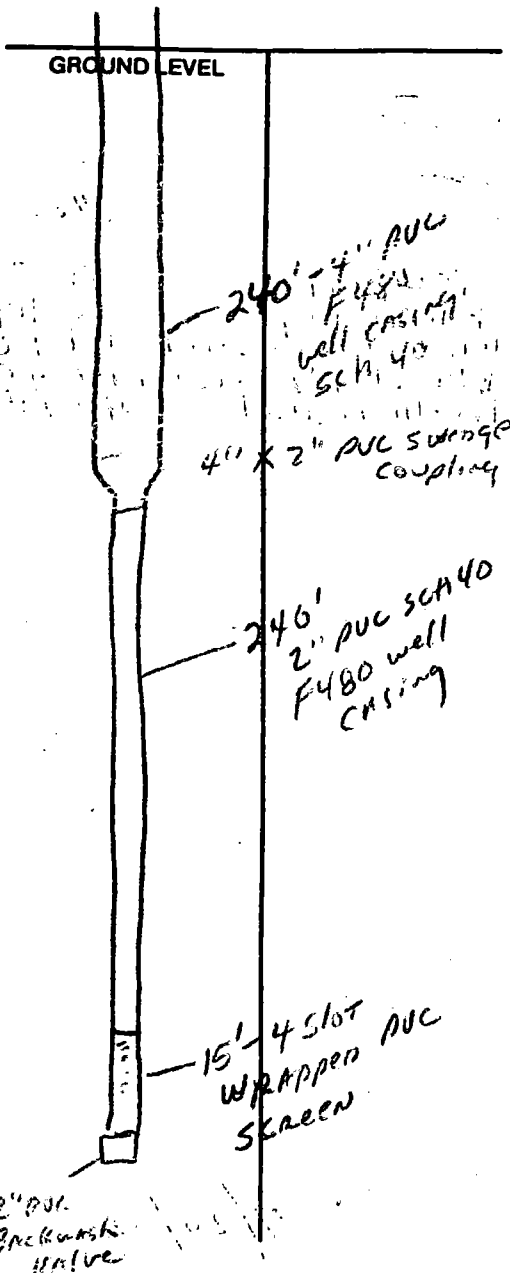

	X		

SECTION 18

Please indicate well location X.

Pump Capacity (GPM)	No. of Stages	Setting Depth	FT.

PUMP TEST

Well yielded _____ GPM with a drawdown of _____ ft. after _____ hours of pumping

LOG DATA

TYPE OF LOG RUN (Circle One): No Log Run
 Electric, Gamma Ray, Density, Sonic, Neutron, Other (Describe)

Name of Organization Running Log _____

GEOLOGIC DATA (Office Use Only)

Surface Elev.	Geologic Unit	Unit Thickness	Depth to Top
Subs. SWL	Date	Analysis	Aquifer Test

Driller's Remarks

If more than one screen, show location of each on sketch.