

MISSISSIPPI DEPARTMENT OF NATURAL RESOURCES

Bureau of Land and Water Resources

Southport Mall

P.O. Box 10631

Jackson, Mississippi 39209

WATER WELL DRILLERS LOG

Jackson
0

10-3-83 date well completed 83 Coors Water Well Sew. firm name Jackson county well located

LANDOWNER: Robert Walker
1401 Seacliff Dr.
Gautier, Miss.
(mailing address) 39553

description of formations encountered	from	to
Sandy Top soil	0	12'
Blue Clay	12'	89'
Coarse sand gravel	89'	120'

WELL LOCATION:
sec. 13 T 8 N R 7 E
1 1/2 miles S of GAUTIER
(distance) (direction) (nearest town)

WELL PURPOSE: Home
(home, irrigation, municipal, industrial)

WELL COMPLETION DATA:

(1) diameter (inches) 2"

(2) total depth (feet) 120'

(3) static water level (feet) 20' below above top of ground.

(4) casing PVC 110' (material) (depth)
2" (size) If telescope see back.

(5) screen 10' 110' (length) (depth to top)
2" (size) PVC (material)

(6) pump 1/2 HP 13 (HP) (yield gpm)
Electric (type power)

(7) electric log No. (yes or no)

(organization running log)

DEPT. OF NATURAL RESOURCES
BUREAU OF LAND & WATER RESOURCES

DEC 19 1983


RECEIVED

(8) How well bottom plugged
Cock Wash Valve

DRILLERS REMARKS:

If well telescopes please sketch and show depths.

GROUND LEVEL

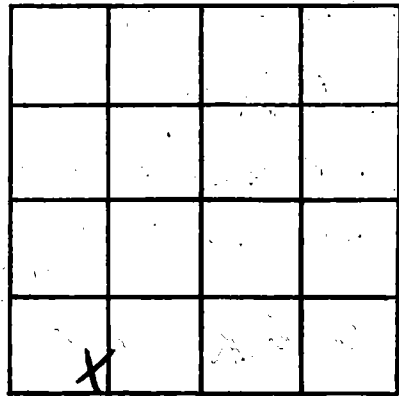

SECTION B

Please indicate well location X.

ADDITIONAL INFORMATION

If more than one screen, show locations of each on sketch.