

MISSISSIPPI DEPARTMENT OF NATURAL RESOURCES

Bureau of Land and Water Resources

Southport Mall

P.O. Box 10631

Jackson, Mississippi 39209

WATER WELL DRILLERS LOG

Jackson

10-4-

1983 Coast Water Well Sew.

Jackson

date well completed

firm name

county well located

LANDOWNER

A. N. Johnson

description of formations encountered

from

to

Box 33,

Top soil

0 1'

Travis Point Mesa.

Brown med. sand

1' 4'

(mailing address) 386 14

WELL LOCATION:

sec. 19 T. 8 N. R. 7 E. S. 4 miles SW of GAUTIER (distance) (direction) (nearest town)

Blue Clay

31' 43'

White coarse sand

43' 104'

WELL PURPOSE:

(home, irrigation, municipal, industrial)

Home

Blue Clay

104' 306'

WELL COMPLETION DATA:

Gray coarse sand

306' 328'

(1) diameter (inches)

2"

Blue Clay & Oyster shell

328' 344'

(2) total depth (feet)

397'

(3) static water level (feet)

26' below above top of ground.

Blue Clay

344' 359'

(4) casing

PVC (material), 387' (depth)

Gray coarse sand

359' 387'

2" (size) if telescope see back.

Blue Clay & Oyster shell

387' 397'

(5) screen

10' (length), 387' (depth to top)

(6) pump

(HP) (yield gpm)

Chlor. (type power)

(7) electric log

No. (yes or no)

(organization running log)

(8) how well bottom plugged

Back wash valve

DEPT. OF NATURAL RESOURCES - BUREAU OF LAND & WATER RESOURCES


DEC 10 1983

DRILLERS REMARKS:

RECEIVED

If well telescopes please sketch and show depths.

GROUND LEVEL

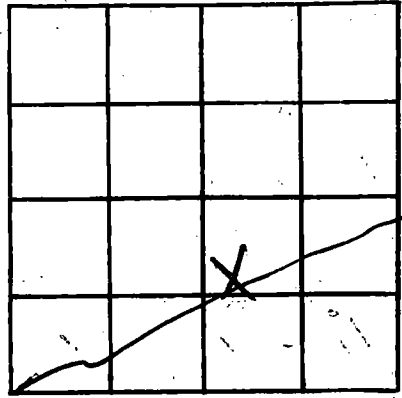

SECTION \_\_\_\_\_

Please indicate well location X.

ADDITIONAL INFORMATION

If more than one screen, show locations of each on sketch.