

MISSISSIPPI DEPARTMENT OF NATURAL RESOURCES
Bureau of Land and Water Resources
 Southport Mall
 P.O. Box 10631
 Jackson, Mississippi 39209
WATER WELL DRILLERS LOG

Jackson
10-11-84

date well completed 10-11-84 Frye Jackson
well name county well located

LANDOWNER Mable Mancief
P.O. Box 547
Pascagoula MS 39567
(mailing address)

description of formations encountered	from	to
Top Soil	0	10
Sand	10	20
Clay & Sand Shale	20	40
Sand	40	80
Sandy Clay	80	120
Clay	120	220
Fine Sand	220	280
Coarse Sand	280	280
		1ble

WELL LOCATION:
 sec. 4 T. 7 N. 2 E. 7 W.
1 miles E of Ocean Springs
(distance) (direction) (nearest town)

WELL PURPOSE:
 (home) Irrigation, municipal, industrial


- WELL COMPLETION DATA:
- diameter (inches) 2
 - total depth (feet) 280
 - static water level (feet) 40 below above top of ground.
 - casing PVC (material), (depth)
no (size) If telescope see back.
 - screen 10' (length), 270 (depth to top)
2" #8 PVC (size), (material)
 - pump 1 HP (HP), 10 (yield gpm)
Elect (type power)
 - electric log no (yes or no)
no (organization running log)
 - how well bottom plugged PVC
Ball Check

DRILLERS REMARKS: good well

1-15-85
STW

If well telescopes please sketch and show depths.

GROUND LEVEL

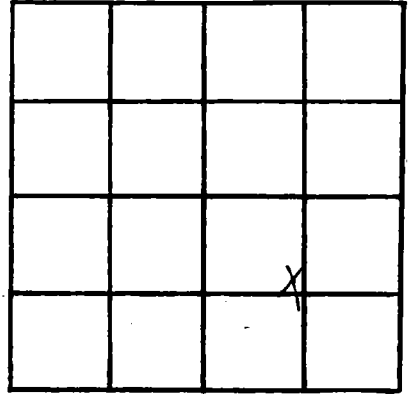

SECTION 25

Please indicate well location X.

ADDITIONAL INFORMATION

If more than one screen, show locations of each on sketch.