

4 miles S of Hwy 90

MISSISSIPPI
BOARD OF WATER COMMISSIONERS
416 North State Street
Jackson, Mississippi 39201

Ocean Springs

WATER WELL DRILLERS LOG

5-16

1969

Lamer Central Co.

firm name

Jackson

county well located

LANDOWNER: St. Andrew's

Creare Corp. of Miss.

Ocean Springs, Miss
(mailing address)

WELL LOCATION:

not available
sec. 4 T 8 N R 7 E
4 miles South of Fountainbleau
(distance) (direction) (nearest town)

WELL PURPOSE: Domestic
(home, irrigation, municipal, industrial)

WELL COMPLETION DATA:

- (1) diameter (inches) 16"
- (2) total depth (feet) 634'
- (3) static water level (feet) 162' below above top of ground.
- (4) casing Steel, 565',
(material) (depth)
16" If telescope see back.
(size) 57" x 8"
- (5) screen 55', 574'
(length) (depth to top)
8", Stainless Steel
(size) (material)
- (6) pump _____ (HP) _____ (yield gpm)
Electric
(type power)
- (7) electric log yes
(yes or no)
Schlumberger
(organization running log)
- (8) how well bottom plugged Valve

description of formations encountered

from to

Yellow Sand	0	2
Brown Sand	2	32
Sandy Clay	32	140
Sand & streaks of Clay	140	208
Clay & streaks of Sand	208	359
Sandy Clay	359	427
Clay	427	541
Sandy Clay	541	565
Sand	565	631
Clay, streaks of fine sand	631	844
Fine Sand	844	849
Sandy Clay (lumpy)	849	1005

APR 20 1969


MISS. Bd. of WATER

DRILLERS REMARKS:

Pump not installed as of this date.

**If well telescopes please
sketch and show depths.**

GROUND LEVEL

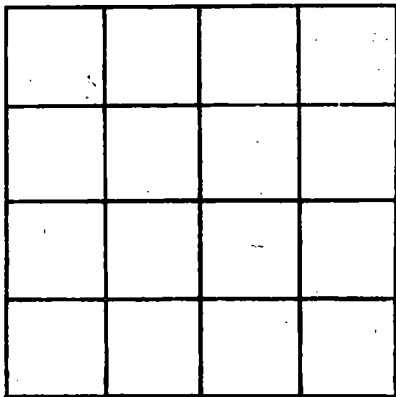

SECTION _____

Please indicate well location X.

ADDITIONAL INFORMATION

**If more than one screen,
show locations of each on sketch.**