

JACKSON MISSISSIPPI BOARD OF WATER COMMISSIONERS

6-14-66

WATER WELL DRILLERS LOG

Date: 6-14, 1966, Driller: H.O. Ridgell County Jackson
(Name)

(1) Owner of Land: Med Carverthon
(Name)
Hunter Miss
(Address)

(2) Location: 1/4, 1/4, Sec. 0 T 7 R 7
6 1/2 miles West of Pascagoula
(distance) (direction) (Nearest Town)

(3) Topography: Flat
(Hilly) (Flat) (Level)

(4) Purpose of Well: Home
(Domestic Irrigation Municipal, Industrial, Other)

Description & Color of Materials Sand, Clay, Red Clay, Shell, etc.	Thick- ness Feet	Depth Feet
Red Clay	6	6
Fine sand	15	21
Blue Clay	21	42
sand & shell	21	63
Blue Clay	15	78
sand red-coarse	21	99
" " "	21	120
Blue Clay	21	141
" " "	10	151
sand med	11	162
Blue Clay	21	183
" " "	6	189
sand fine med	10	199
Blue Clay	5	204
Blue Clay & Toyon shell	21	225
Fine sand & Chert	21	246
" " "	21	267
sand med-coarse	21	288
" Coarse	21	309
" " "	6	315
Blue Clay	15	330
" " "	21	351
Blue Clay & hardy shell	21	372
Blue Clay	21	393
Blue Clay & hardy shell	21	414
Blue Clay	21	435
" " "	15	450
Fine sand	6	456
" " "	16	472
Blue Clay	5	477
" " "	21	498
" " "	21	519

Information upon completion of well:

(1) Diameter 2" inches.

(2) Total Depth 750 feet.

(3) Water Level 6 feet below top of ground.


(4) Cased to _____ Size _____

(5) Screen: Size 2", Length 10'

(6) Were any formations sealed against pollution?
 yes, no.

If YES depth of formation _____
 Why _____

Drillers Remarks: _____

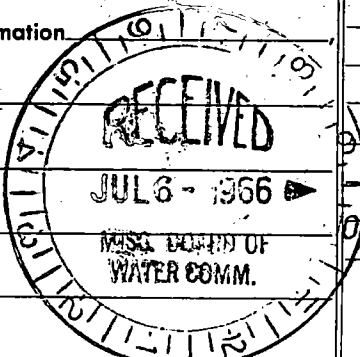

(Use Back Side)

Well No. _____

Blue Clay	21	540
" "	21	561
" "	21	582
" "	21	603
" "	21	624
Sandy Shale	21	645
" "	21	666
Green Clay	21	687
" "	13	698
Sandstone	10	708
" " "	21	729
" Mid. Course	21	750